

State of Kansas
NOTICE OF INTENTION TO DRILL
(see rules on reverse side)

CARD MUST BE TYPED

CARD MUST BE SIGNED
CORRECTED INTENT

** CORRECTED INTENT ** 9 01 1985
Starting Date: month day year

API Number 15- 007-22,074 -0000

OPERATOR: License # 4285
Name Craig/Stephenson Corporation
Address Box 2646
City/State/Zip Ponca City, OK 74602
Contact Person Jeff Wolfe
Phone 405-762-9062

* C W/2 NW NE 30 31 14 East
(location) Sec Twp S, Rge West

* 4620 Ft North from Southeast Corner of Section
2310 Ft West from Southeast Corner of Section
(Note: Locate well on Section Plat on reverse side)

CONTRACTOR: License # 5380
Name Eagle Drilling, Inc.
City/State Wichita, KS 67208

Nearest lease or unit boundary line 330 feet.
County Barber
Lease Name Thunderbird Well# 1

Well Drilled For: Well Class: Type Equipment:
 Oil Swd Infield Mud Rotary
 Gas Inj Pool Ext. Air Rotary
 OWWO Expl Wildcat Cable

Domestic well within 330 feet: yes no
Municipal well within one mile: yes no

If OWWO: old well info as follows:

Depth to Bottom of fresh water 100 feet
Lowest usable water formation
Depth to Bottom of usable water 200 feet
Surface pipe by Alternate: 1 2
Surface pipe to be set 250 feet
Conductor pipe if any required None feet
Ground surface elevation feet MSL

Operator
Well Name
Comp Date Old Total Depth
Projected Total Depth 4800 feet
Projected Formation at TD Arbuckle
Expected Producing Formations Simpson

This Authorization Expires 2-16-86
Approved By R.H.S. 23-85 ORIG-8-16-85
WAS: CNW-NE
1980' FFL

I certify that we will comply with K.S.A. 55-101, et seq., plus eventually plugging hole to K.C.C. specifications.
Date 8-22-85 Signature of Operator or Agent Title


Geologist

** CORRECTED INTENT **

Must be filed with the K.C.C. five (5) days prior to commencing well
This card void if drilling not started within six (6) months of date received by K.C.C.

Important procedures to follow :

**A Regular Section of Land
1 Mile = 5,280 Ft.**

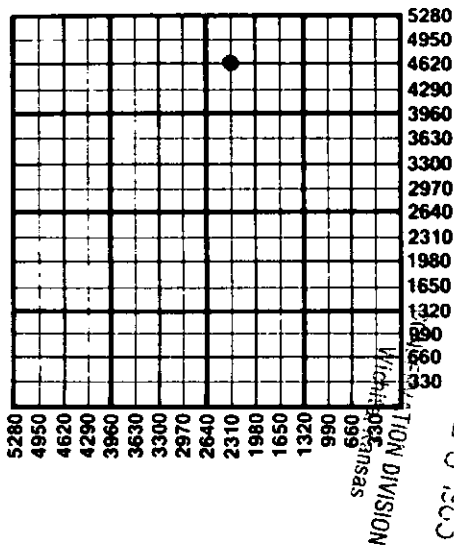

1. Notify District office before setting surface casing.
2. Set surface casing by circulating cement to the top.
3. File completion forms ACO-1 with K.C.C. within 90 days of well completion, following instructions on ACO-1, side 1, and including copies of wireline logs.
4. Notify District office 48 hours prior to old well workover or re-entry.
5. Prior to plugging, prepare a plugging plan, then obtain agreement from the appropriate district office for an approved plugging plan.
6. Submit plugging report (CP-4) to K.C.C. after plugging is completed.
7. Obtain an approved injection docket number before disposing of salt water.
8. Notify K.C.C. within 10 days when injection commences or terminates.
9. If an alternate 2 completion, cement in the production pipe from below any usable water to surface within 120 days of spud date.

**State Corporation Commission of Kansas
Conservation Division
200 Colorado Derby Building
Wichita, Kansas 67202
(316) 263-3238**

RECEIVED
AUG 23 1985
STATE CORPORATION COMMISSION