

CORRECTED INTENT

CARD MUST BE TYPED

NOTICE OF INTENTION TO DRILL

(see rules on reverse side)

State of Kansas

CORRECTED INTENT

CORRECTION
1-14-85
CARD MUST BE SIGNED

Starting Date: January 10, 1985
month day year

OPERATOR: License # 7275
Name Craig/Stephfield Oil & Gas, Inc.
Address 111 N. Third P. O. Box 2646
City/State/Zip Ponca City, OK 74602
Contact Person Larry K. Stephenson
Phone (405) 762-9062

CONTRACTOR: License # 5829
Name Aldebaran Drilling Co., Inc.
City/State Pratt, KS 67124

Well Drilled For:	Well Class:	Type Equipment:
<input checked="" type="checkbox"/> Oil	<input type="checkbox"/> Swd	<input checked="" type="checkbox"/> Mud Rotary
<input type="checkbox"/> Gas	<input type="checkbox"/> Inj	<input type="checkbox"/> Air Rotary
<input type="checkbox"/> OWWO	<input type="checkbox"/> Expl	<input type="checkbox"/> Cable
	<input type="checkbox"/> Wildcat	

If OWWO: old well info as follows:

Operator
Well Name
Comp Date Old Total Depth
Projected Total Depth 4800 feet
Projected Formation at TD Arbuckle
Expected Producing Formations Viola

I certify that we will comply with K.S.A. 55-101, et seq., plus eventually plugging hole to K.C.C. specifications.

Date 1-11-85 Signature of Operator or Agent

CORRECTED INTENT

API Number 15- 007-21,978-0000

* NE SE NE Sec 30 Twp 31 S, Rge 14 ☐ East
(location) ☒ West

3630 Ft North from Southeast Corner of Section
* 330 Ft West from Southeast Corner of Section
(Note: Locate well on Section Plat on reverse side)

Nearest lease or unit boundary line 330 feet.
County Barber
Lease Name Thunderbird Ranch Well# 1-30
Domestic well within 330 feet: ☐ yes ☒ no
Municipal well within one mile: ☐ yes ☒ no


Depth to Bottom of fresh water 50 feet
Lowest usable water formation Quaternary
Depth to Bottom of usable water 200 feet
Surface pipe by Alternate: 1 ☒ 2 ☐
Surface pipe to be set 350 feet
Conductor pipe if any required feet
Ground surface elevation NA feet MSL
This Authorization Expires 6-17-85
Approved By 12-17-84

was: NESE NW
2970 FEL
Title Geologist

Must be filed with the K.C.C. five (5) days prior to commencing well
This card void if drilling not started within six (6) months of date received by K.C.C.

Important procedures to follow :

A Regular Section of Land
1 Mile = 5,280 Ft.

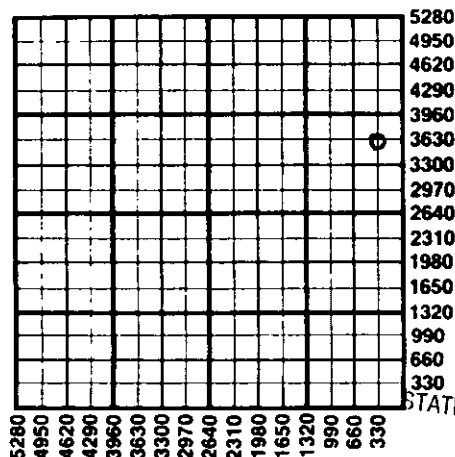

1. Notify District office before setting surface casing.
2. Set surface casing by circulating cement to the top.
3. File completion forms ACO-1 with K.C.C. within 90 days of well completion, following instructions on ACO-1, side 1, and including copies of wireline logs.
4. Notify District office 48 hours prior to old well workover or re-entry.
5. Prior to plugging, prepare a plugging plan, then obtain agreement from the appropriate district office for an approved plugging plan.
6. Submit plugging report (CP-4) to K.C.C. after plugging is completed.
7. Obtain an approved injection docket number before disposing of salt water.
8. Notify K.C.C. within 10 days when injection commences or terminates.
9. If an alternate 2 completion, cement in the production pipe from below any usable water to surface within 120 days of spud date.

RECEIVED
STATE CORPORATION COMMISSION

JAN 11 1985
1-11-85
CONSERVATION DIVISION
Wichita, Kansas

State Corporation Commission of Kansas
Conservation Division
200 Colorado Derby Building
Wichita, Kansas 67202
(316) 263-3238