

CARD MUST BE TYPED

State of Kansas
NOTICE OF INTENTION TO DRILL

CARD MUST BE SIGNED

(see rules on reverse side)

Starting Date: 9 10 1985
month day year

API Number 15- 007-22,073-0000

OPERATOR: License # 4285

..... N¹/₂ . N¹/₂ . Sec . 31 . Twp 30 . S, Rge 14 .
(location) East West

Name Craig/Stephenson Corporation

Address Box 2646

City/State/Zip Ponca City, OK 74602

Contact Person Jeff Wolfe

Phone 405-762-9062

4620
2640
..... Ft North from Southeast Corner of Section
..... Ft West from Southeast Corner of Section
(Note: Locate well on Section Plat on reverse side)

CONTRACTOR: License # 5380

Name Eagle Drilling, Inc.

City/State Wichita, KS

Nearest lease or unit boundary line 1980 feet.

County Barber

Lease Name Mills Well# 1

Domestic well within 330 feet : yes no

Municipal well within one mile : yes no

Well Drilled For: Well Class: Type Equipment:

Oil Swd Infield Mud Rotary

Gas Inj Pool Ext. Air Rotary

OWWO Expl Wildcat Cable

Depth to Bottom of fresh water 150 feet

Lowest usable water formation Permian

Depth to Bottom of usable water 200 feet

Surface pipe by Alternate : 1 2

Surface pipe to be set 250 feet

Conductor pipe if any required None feet

Ground surface elevation feet MSL.

This Authorization Expires 8-16-85

Approved By RCH SORSDHE

If OWWO: old well info as follows:

Operator

Well Name

Comp Date Old Total Depth

Projected Total Depth 3800 feet

Projected Formation at TD .. Douglas

Expected Producing Formations Douglas Sand

I certify that we will comply with K.S.A. 55-101, et seq., plus eventually plugging hole to K.C.C. specifications.

Date 8-15-85 Signature of Operator or Agent


Robert F. Eisch

President, Eagle Drlg.

RECEIVED
STATE CORPORATION COMMISSION
Must be filed with the K.C.C. five (5) days prior to commencing well
This card void if drilling not started within six (6) months of date received by K.C.C.

AUG 16 1985
8-16-85
CONSERVATION DIVISION
Wichita, Kansas

A Regular Section of Land
1 Mile = 5,280 Ft.

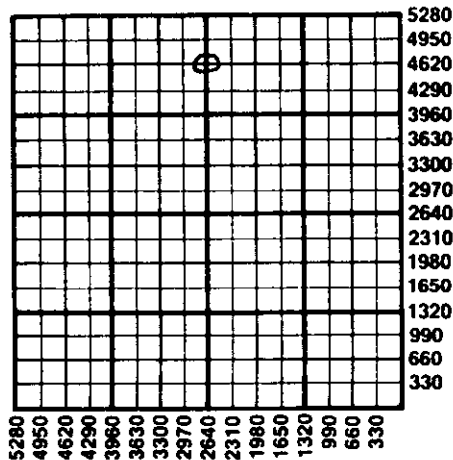

Important procedures to follow :

1. Notify District office before setting surface casing.
2. Set surface casing by circulating cement to the top.
3. File completion forms ACO-1 with K.C.C. within 90 days of well completion, following instructions on ACO-1, side 1, and including copies of wireline logs.
4. Notify District office 48 hours prior to old well workover or re-entry.
5. Prior to plugging, prepare a plugging plan, then obtain agreement from the appropriate district office for an approved plugging plan.
6. Submit plugging report (CP-4) to K.C.C. after plugging is completed.
7. Obtain an approved injection docket number before disposing of salt water.
8. Notify K.C.C. within 10 days when injection commences or terminates.
9. If an alternate 2 completion, cement in the production pipe from below any usable water to surface within 120 days of spud date.

State Corporation Commission of Kansas
Conservation Division
200 Colorado Derby Building
Wichita, Kansas 67202
(316) 263-3238