

EFFECTIVE DATE: 11-12-90

FORM MUST BE TYPED
FORM C-1 4/90

State of Kansas
NOTICE OF INTENTION TO DRILL

FORM MUST BE TYPED
ALL BLANKS MUST BE FILLED

Must be approved by the K.C.C. five (5) days prior to commencing well

Expected Spud Date 12 month 10 day 90 year C. W. 1/2 NW Sec 25 Twp 19 S, Rg 22 East West

OPERATOR: License # 8996
Name: Mid Continent Resources, Inc.
Address: P.O. Box 399
City/State/Zip: Garden City, Ks 67846
Contact Person: Scott Corsair
Phone: 913-398-2270

CONTRACTOR: License #: 8241
Name: Empahsis Oil Operations

Well Drilled For: Well Class: Type Equipment:
 Oil ... Inj Infield Mud Rotary
... Gas ... Storage ... Pool Ext. ... Air Rotary
... OAWD ... Disposal ... Wildcat ... Cable
... Seismic; ... # of Holes

If OAWD: old well information as follows:
Operator:
Well Name:
Comp. Date: Old Total Depth

Directional, Deviated or Horizontal wellbore? yes no
If yes, total depth location:

3960 feet from South Line of Section
4620 feet from East line of Section
(Note: Locate well on Section Plat on Reverse Side)
County: Ness
Lease Name: Borger Well #: 2
Field Name: Schaben
Is this a Prorated Field? yes no
Target Formation(s): Mississippian
Nearest lease or unit boundary: 660'
Ground Surface Elevation: 2280 est. feet MSL
Domestic well within 330 feet: yes no
Municipal well within one mile: yes no
Depth to bottom of fresh water: 100' 150'
Depth to bottom of usable water: 600'
Surface Pipe by Alternate: 1 2
Length of Surface Pipe Planned to be set: 450'
Length of Conductor pipe required: N/A
Projected Total Depth: 4400'
Formation at Total Depth: Mississippian
Water Source for Drilling Operations:
... well farm pond other
DWR Permit #:
Will Cores Be Taken?: yes no
If yes, proposed zone:

AFFIDAVIT

The undersigned hereby affirms that the drilling, completion and eventual plugging of this well will comply with K.S.A. 55-101, et. seq.

- It is agreed that the following minimum requirements will be met:
1. The appropriate district office shall be notified before setting surface pipe;
 2. The minimum amount of surface pipe as specified above shall be set by circulating cement to the top; in all cases surface pipe shall be set through all unconsolidated materials plus a minimum of 20 feet into the underlying formation;
 3. If the well is dry, a plugging proposal shall be submitted to the district office. An agreement between the operator and the district office on plug length and placement is necessary prior to plugging;
 4. The appropriate district office will be notified before well is either plugged or production casing is cemented in;
 5. If an Alternate II completion, production pipe shall be cemented from below any usable water to surface within 120 days of spud date. In all cases, notify district office prior to any cementing.

I hereby certify that the statements made herein are true and to the best of my knowledge and belief.
Date: 10-11-90 Signature of Operator or Agent: Scott Corsair Title: Agent

FOR KCC USE:
API # 15- 135-23,524-0000
Conductor pipe required None feet
Minimum surface pipe required 250 feet per Alt. # 2
Approved by: MD 11-7-90
EFFECTIVE DATE: 11-12-90
This authorization expires: 5-7-91
(This authorization void if drilling not started within 6 months of effective date.)
Spud date: _____ Agent: _____

RECEIVED
STATE CORPORATION COMMISSION
10-24-90
OCT 24 1990
CONSERVATION DIVISION
Wichita, Kansas

25 19 2200


- REMEMBER TO:
- File Drill Pit Application (form CP-3) with Intent to Drill;
 - File Completion Form ACP within 120 days of spud date;
 - File acreage attribution plat according to field proration orders;
 - Notify appropriate district office 48 hours prior to workover or re-entry;
 - Submit plugging report (CP-4) after plugging is completed;
 - Obtain written approval before disposing or injecting salt water.

PLAT OF ACREAGE ATTRIBUTABLE TO A WELL

State Corporation Commission, Conservation Division
200 Colorado Derby Bldg. Wichita, Kansas 67202

OPERATOR Mid Continent Resources. LOCATION OF WELL:
 LEASE Borger 3960' feet north of SE corner
 WELL NUMBER 2 4620' feet west of SE corner
 FIELD Schaben Sec. 25 T 19S R 22 W
 COUNTY Ness
 NO. OF ACRES ATTRIBUTABLE TO WELL 80 IS SECTION X REGULAR IRREGULAR?
 DESCRIPTION OF ACREAGE W1/2 NW 1/4 IF IRREGULAR, LOCATE WELL FROM NEAREST
 CORNER BOUNDARY.

NOTE: If plat depicted is insufficient for your circumstances, you may attach your own scaled or surveyed plat.

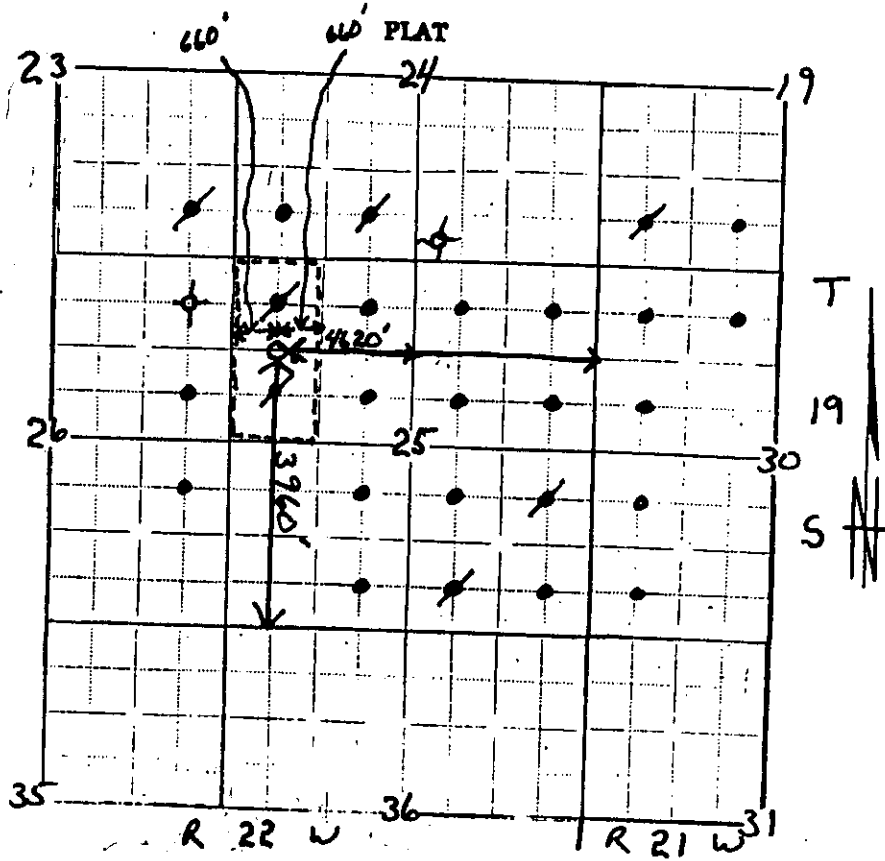

In plotting the proposed location of the well, you must show:

- 1) The manner in which you are using the depicted plat by identifying section lines, i.e.: section, section with 8 surrounding partial sections, 4 sections, 16 sections, etc.;
- 2) the well's location relative to the location of other wells producing from the same common source of supply in adjoining drilling units, pursuant to K.A.R. 82-3-108, 82-3-207, 82-3-312, or special orders of the Commission;
- 3) the distance of the proposed drilling location from the section's east and south lines; and
- 4) the distance to the nearest lease or unit boundary line.

I hereby certify that the statements do here and to the best of my knowledge and belief.

Signature of Operator or Agent: Scott Crowe
 Date 10-11-1990 Title Agent