

CARD MUST BE TYPED

State of Kansas  
**NOTICE OF INTENTION TO DRILL**  
(see rules on reverse side)

CARD MUST BE SIGNED

Starting Date: July 10 1984  
month day year

API Number 15- 007-21,867-0000

OPERATOR: License # 5364  
Name Beren Corporation  
Address 970 Fourth Financial Center  
City/State/Zip Wichita, Kansas 67202  
Contact Person Don Beauchamp  
Phone 316-265-3311

NW SW SE ... Sec 26 Twp 32 S, Rge 11  
(location)  East  West

990 Ft North from Southeast Corner of Section  
2310 Ft West from Southeast Corner of Section  
(Note: Locate well on Section Plat on reverse side)

CONTRACTOR: License # 5147  
Name BEREDCO INC  
City/State Wichita, Kansas 67202

Nearest lease or unit boundary line 330 feet  
County Barber

Lease Name Schiff - Kimball Well# 2

Domestic well within 330 feet:  yes  no  
Municipal well within one mile:  yes  no

Well Drilled For: Well Class: Type Equipment:  
 Oil  Swd  Infield  Mud Rotary  
 Gas  Inj  Pool Ext.  Air Rotary  
 OWWO  Expl  Wildcat  Cable

Depth to Bottom of fresh water 15 35 mhc feet  
Lowest usable water formation White Horse (Permian)  
Depth to Bottom of usable water 200 2.00 feet

If OWWO: old well info as follows:

Surface pipe by Alternate: 1  2   
Surface pipe to be set 280 feet  
Conductor pipe if any required NA feet  
Ground surface elevation 1510 feet MSL  
This Authorization Expires 1/2/85  
Approved By 7/2/84

Operator

Well Name

Comp Date Old Total Depth

Projected Total Depth 2850 feet

Projected Formation at TD Tarkio

Expected Producing Formations Tarkio

I certify that we will comply with K.S.A. 55-101, et seq., plus eventually plugging hole to K.C.C. specifications.

Date 6/29/84 Signature of Operator or Agent

Title Geol. Dept. Sec.

MHC/UDHE 7-2-84


Must be filed with the K.C.C. five (5) days prior to commencing well  
This card void if drilling not started within six (6) months of date received by K.C.C.

RECEIVED  
STATE CORPORATION COMMISSION

Important procedures to follow: FILE: 02 1984  
7-2-84

CONSERVATION DIVISION  
Wichita, Kansas

**A Regular Section of Land**  
1 Mile = 5,280 Ft.

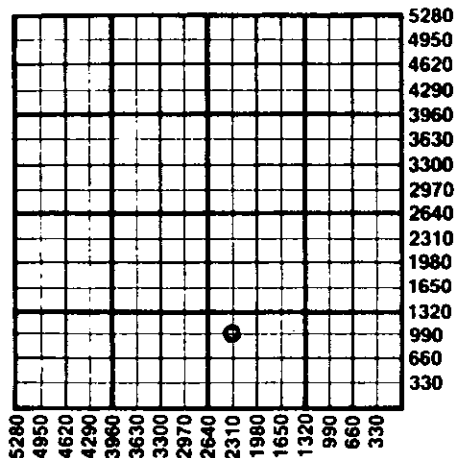

1. Notify District office before setting surface casing.
2. Set surface casing by circulating cement to the top.
3. File completion forms ACO-1 with K.C.C. within 90 days of well completion, following instructions on ACO-1, side 1, and including copies of wireline logs.
4. Notify District office 48 hours prior to old well workover or re-entry.
5. Prior to plugging, prepare a plugging plan, then obtain agreement from the appropriate district office for an approved plugging plan.
6. Submit plugging report (CP-4) to K.C.C. after plugging is completed.
7. Obtain an approved injection docket number before disposing of salt water.
8. Notify K.C.C. within 10 days when injection commences or terminates.
9. If an alternate 2 completion, cement in the production pipe from below any usable water to surface within 120 days of spud date.

State Corporation Commission of Kansas  
Conservation Division  
200 Colorado Derby Building  
Wichita, Kansas 67202  
(316) 263-3238