

This form shall be filed in duplicate with the Kansas Corporation Commission, 200 Colorado Derby Building, Wichita, Kansas 67202, within ten days after the completion of the well, regardless of how the well was completed.

Attach separate letter of request if the information is to be held confidential. If confidential, only file one copy. Information on side one will be of public record and side two will then be held confidential.

Circle one: (Oil) Gas, Dry, SWD, OWWO, Injection. Type and complete ALL sections. Applications must be filed for dual completion, commingling, SWD and injection, T.A.

Attach wireline logs (i.e. electrical log, sonic log, gamma ray neutron log, etc.). KCC # (316) 263-3238. (Rules 82-2-105 & 82-2-125)

OPERATOR Rupe Oil Company, Inc.

API NO. 15-007-21,381-00-00

ADDRESS P.O. Box 2273  
Wichita, KS 67201

COUNTY Barber

FIELD PALMER

\*\*CONTACT PERSON W. G. Clement  
PHONE 316-262-3748

PROD. FORMATION Massey & Miss.

LEASE Palmer "C"

PURCHASER Koch Oil Company

WELL NO. 1

ADDRESS P.O. Box 2256  
Wichita, KS 67201

WELL LOCATION NW NE


660 Ft. from W Line and

660 Ft. from N Line of

the NE/4 SEC-30 TWP-32 RGE-13W

DRILLING Aldebaran Drilling Co., Inc.  
CONTRACTOR ADDRESS P.O. Box 18611  
Wichita, KS 67207

WELL PLAT

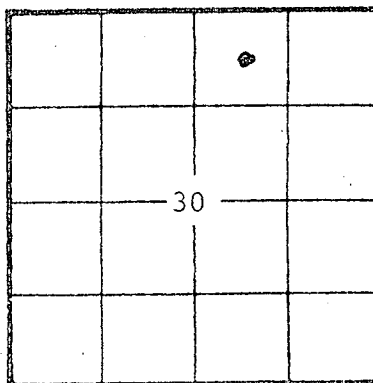

KCC   
KGS   
(Office Use)

PLUGGING CONTRACTOR ADDRESS

TOTAL DEPTH 4615 PBDT 4582

SPUD DATE 1-5-82 DATE COMPLETED 4-12-82

ELEV: GR 1834' DF KB 1843'

DRILLED WITH (CABLE) (ROTARY) (AIR) TOOLS

Amount of surface pipe set and cemented 320 feet DV Tool Used? NO

AFFIDAVIT

STATE OF KANSAS, COUNTY OF SEDGWICK SS, I, William

G. Clement OF LAWFUL AGE, BEING FIRST DULY SWORN UPON HIS OATH,

DEPOSES THAT HE IS Geologist (FOR)(OF) Rupe Oil Company, Inc.

OPERATOR OF THE Palmer "C" LEASE, AND IS DULY AUTHORIZED TO MAKE

THIS AFFIDAVIT FOR AND ON THE BEHALF OF SAID OPERATOR, THAT WELL NO. 1 ON

SAID LEASE HAS BEEN COMPLETED AS OF THE 12th DAY OF April, 19 82, AND THAT

ALL INFORMATION ENTERED HEREIN WITH RESPECT TO SAID WELL IS TRUE AND CORRECT.

FURTHER AFFIANTS SAITH NOT.

(S) William G. Clement

SUBSCRIBED AND SWORN BEFORE ME THIS 20th DAY OF April, 19 82.

Faye W. Leach  
NOTARY PUBLIC, Faye W. Leach

MY COMMISSION EXPIRES: September 30, 1985

\*\*The person who can be reached by phone regarding any questions concerning this information. Within 45 days of completion, a witnessed initial test by the Commission is required if the well produces more than 25 BOPD or is located in a Basic Order Pool.

