


STATE OF KANSAS  
STATE CORPORATION COMMISSION

WELL PLUGGING RECORD  
OR  
FORMATION PLUGGING RECORD

Strike out upper line  
when reporting plug-  
ging off formations.

Give All Information Completely  
Make Required Affidavit  
Mail or Deliver Report to:  
Conservation Division  
State Corporation Commission  
800 Bitting Building  
Wichita, Kansas

NORTH

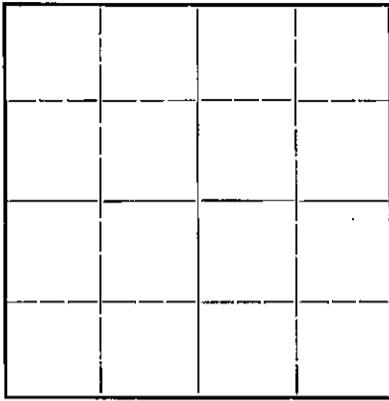

Locate well correctly on above  
Section Plat

County. Sec. 13 Twp. 31 Rge. (E) 14 (W)

Location as "NE 1/4 NW 1/4 SW 1/4" or footage from lines. SE. 1/4

Lease Owner. Fryor & Lockhart Inc. Well No. 1

Lease Name. Risps

Office Address. 820 Union Nat Bank Bldg. Wichita, Kans.

Character of Well (completed as Oil, Gas or Dry Hole) Dry Hole.

Date well completed. Feb. 1st, 19 42

Application for plugging filed. Feb. 5th, 19 42

Application for plugging approved. Feb. 5th, 19 42

Plugging commenced. Feb 5th. 19 42

Plugging completed. Feb. 5th. 19 42

Reason for abandonment of well or producing formation. Dry

If a producing well is abandoned, date of last production. 19

Was permission obtained from the Conservation Division or its agents before plugging was com-  
menced? Yes.

Name of Conservation Agent who supervised plugging of this well. C. T. Alexander

Producing formation. None Depth to top. Bottom. Total Depth of Well. 4586 1/2 Feet

Show depth and thickness of all water, oil and gas formations.


OIL, GAS OR WATER RECORDS

CASING RECORD

Formation	Content	From	To	Size	Put In	Pulled Out
	<u>Top</u>					
<u>Anhydrite</u>	<u>545'</u>			<u>15"</u>	<u>171'</u>	<u>None.</u>
<u>Lansing</u>	<u>3787'</u>					
<u>Mississippi</u>	<u>4258'</u>					
<u>Viola</u>	<u>6350'</u>					
<u>Simpson</u>	<u>6477'</u>					
<u>Arbuckle</u>	<u>6570'</u>					

Describe in detail the manner in which the well was plugged, indicating where the mud fluid was placed and the method or methods used in introducing it into the hole. If cement or other plugs were used, state the character of same and depth placed, from \_\_\_\_\_ feet to \_\_\_\_\_ feet for each plug set.

Hole was filled with mud from 4586 1/2 Ft. to 171ft. Then Cement Bridge from 171ft. to 161ft. 10 Sx Cement. Then mud to 24ft. Then Cement Bridge from 24 ft. to 4ft. 10 Sx Cement. Then mud to top of surface.

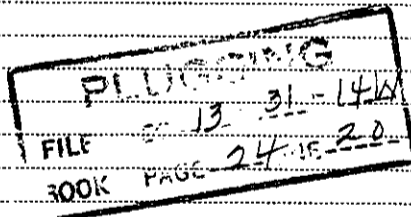

(If additional description is necessary, use BACK of this sheet)

Correspondence regarding this well should be addressed to. Fryor & Lockhart Inc.  
Address 820 Union Nat Bank Bldg. Wichita, Kansas.

STATE OF Kansas, COUNTY OF Sedgewick, SS.

F. P. Hendrick (employee of owner) or (owner or operator) of the above-described well, being first duly sworn on oath, says: That I have knowledge of the facts, statements, and matters herein contained and the log of the above-described well as filed and that the same are true and correct. So help me God.

(Signature) F. P. Hendrick

820 Union Nat Bank Bldg. Wichita  
(Address)

SUBSCRIBED AND SWORN to before me this 9th day of February, 19 42

My commission expires Oct 25, 1942

Notary Public.

# PRYOR & LOCKHART, INC. WELL RECORD AND LOG

WELL NO. 1 \_\_\_\_\_ FARM \_\_\_\_\_

LOCATION 3 1/2 CORNER OF E & S CHARTER SEC. 13 TWP. 31 RANGE 14 N

COUNTY PARSONS \_\_\_\_\_ OPERATOR \_\_\_\_\_

RIG COMMENCED DECEMBER 28 1941 } \_\_\_\_\_ CONTRACTOR \_\_\_\_\_

RIG COMPLETED DECEMBER 30 1941 } \_\_\_\_\_ CONTRACTOR \_\_\_\_\_

DRILLING COMMENCED JANUARY 6 1942 } \_\_\_\_\_ CONTRACTOR \_\_\_\_\_

DRILLING COMPLETED DECEMBER 1 1942 } \_\_\_\_\_ CONTRACTOR \_\_\_\_\_

ELEVATION \_\_\_\_\_

## CASING AND TUBING

SIZE	WEIGHT PER FOOT	PUT IN WELL		PULLED		REMARKS
		FEET	INCHES	FEET	INCHES	
1 1/2" O.D.	40	172				

## FORMATION

NAME	TOP	BOTTOM	THICKNESS	REMARKS

**PLUGGING**


BOOK PAGE 24 LINE 20

TOTAL DEPTH 4570 FEET

SHOT \_\_\_\_\_ 19\_\_\_\_ TREATED \_\_\_\_\_ 19\_\_\_\_ BY \_\_\_\_\_

TREATMENT OR SHOT \_\_\_\_\_ FORMATION \_\_\_\_\_


POTENTIAL \_\_\_\_\_ DATE \_\_\_\_\_ 19\_\_\_\_ GRAVITY \_\_\_\_\_

STATE OF \_\_\_\_\_ COUNTY OF \_\_\_\_\_, ss.

I, the undersigned, being duly sworn, on oath state that the above statement and log on reverse side is a true and correct record and log of the well drilled at the location above described.

Subscribed and sworn to before me this \_\_\_\_\_ day of \_\_\_\_\_, 19\_\_\_\_

My commission expires \_\_\_\_\_

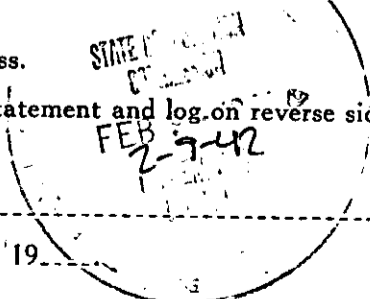

NOTARY PUBLIC

FORMATION	FROM	TO	FORMATION	FROM	TO
Collar	—	5	Lime	3460	3475
Sand	5	75	Broken Lime & Shale	3475	3530
Shale	75	80	Lime	3530	3530
Red Rock & Lime Shells	80	204	Lime Broken	3530	3533
Red Rock & Shale	204	543	Shale	3533	3535
Lime	543	550	Lime	3535	3539
Ogg & Red Rock	550	550	Shale & Lime Shells	3539	3539
Blue Shale	530	555	Sticky Shale	3529	3533
Red Rock & Shale	555	507	Sandy Lime	3525	3572
Red Shale	507	550	Lime	3572	3775
Blue Shale	550	510	Shale	3775	3755
Red Rock	510	595	Lime	3755	3805
Blue Shale	595	1000	Broken Lime	3805	3825
Shale	1000	1105	Lime	3815	3857
Shale & Salt	1105	1340	Lime Hard	3857	3846
Shells & Shale	1340	1430	Soft Lime	3846	3872
Lime	1430	1450	Lime Hard	3872	3875
Shale	1450	1520	Lime	3875	3881
Shells & Shale	1520	1535	Soft Lime	3881	3830
Lime	1535	1600	Lime	3830	3944
Shale	1600	1620	Soft Lime	3944	3833
Lime	1620	1635	Lime	3833	3888
Shale	1635	1655	Broken Lime	3888	3907
Lime	1655	1675	Lime	3907	4043
Shale	1675	1695	Soft Lime	4043	4054
Lime	1695	1720	Hard Lime	4054	4055
Shale & Lime	1720	1730	Lime & Shale	4055	4097
Broken Lime & Shale	1730	1820	Lime & Shale Brecks	4097	4129
Lime	1820	1912	Lime & Shale	4129	4160
Shale	1912	1920	Shale	4175	4165
Shale & Lime Broken	1920	1940	Shale & Shells	4165	4205
Shale	1940	1950	Lime & Shale Brecks	4205	4224
Shale & Lime	1950	1975	Lime Hard	4224	4233
Lime	1975	2035	Lime & Chert	4233	4255
Shale	2035	2050	Lime	4255	4258
Lime	2050	2063	Chert	4258	4276
Shale	2063	2082	Lime	4276	4279
Lime	2082	2120	Lime Hard	4279	4289
Shale	2120	2130	Shale & Lime	4289	4304
Lime & Shale Brecks	2130	2135	Shale	4304	4342
Lime	2135	2347	Cherty Lime	4342	4350
Shale	2347	2347	Viola Lime	4350	4364
Lime	2347	2382	Shale & Shells	4364	4386
Shale	2382	2375	Lime	4386	4406
Lime & Shale	2375	2420	Cherty Lime	4406	4419
Shale	2420	2450	Chert & Lime	4419	4439
Shale & Lime	2450	2475	Cherty Lime & Shale	4439	4459
Lime	2475	2505	Lime & Shale	4459	4479
Broken Lime	2505	2560	Shale	4479	4494
Lime & Shale Brecks	2560	2610	Cored for Gypsum Seal	4494	4512
Lime	2610	2640	Sand & Shale	4512	4530
Shale	2640	2660	Shale	4530	4570
Shale & Lime	2660	2675	Sandy Lime	4570	4585
Lime	2675	2700			
Lime & Shale Brecks	2700	2745			
Shale	2745	2750			
Lime	2750	2859			
Shale & Lime	2859	2917			
Lime	2917	2970			
Sand	2970	2975			
Lime	2975	2985			
Lime Broken	2985	3040			
Lime	3040	3079			
Soft Lime	3079	3080			
Lime	3080	3141			
Shale	3141	3200			
Lime	3200	3208			
Lime Hard	3208	3235			
Soft Lime	3235	3254			
Broken Lime	3254	3310			
Lime	3310	3350			
Soft Lime	3350	3352			
Lime	3352	3355			
Soft Lime	3355	3374			
Soft Lime	3374	3480			