

STATE OF KANSAS
STATE CORPORATION COMMISSION

WELL PLUGGING RECORD

Give All Information Completely
Make Required Affidavit
Mail or Deliver Report to
Conservation Division
State Corporation Comm.
245 North Water
Wichita, KS 67202

Barber County, Sec. 12 Twp. 31S Rge. 14W E/W
Location as "NE/CNW $\frac{1}{4}$ SW $\frac{1}{4}$ " or footage from lines
C-NE NW

Lease Owner Mallonee-Mahoney, Inc.
Lease Name Lake Well No. 1

Office Address _____
Character of Well (Completed as Oil, Gas or Dry Hole) _____
Gas


Date Well completed 6-30- 19 76
Application for plugging filed 9-21- 19 77
Application for plugging approved _____ 19 _____
Plugging commenced 10-3- 19 77
Plugging completed 10-6- 19 77

Reason for abandonment of well or producing formation _____
NON PRODUCING

If a producing well is abandoned, date of last production _____
19 _____

Was permission obtained from the Conservation Division or
its agents before plugging was commenced? Yes

Name of Conservation Agent who supervised plugging of this well Bill Owens
Producing formation _____ Depth to top 2242 Bottom 2250 Total Depth of Well 3168
Show depth and thickness of all water, oil and gas formations.

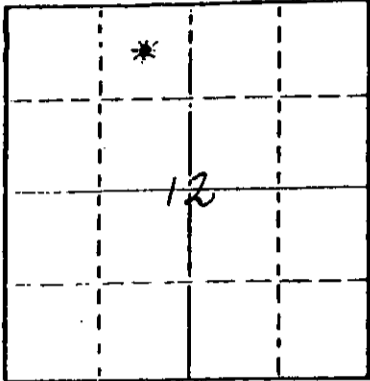

Locate well correctly on above
Section Plat

OIL, GAS OR WATER RECORDS

CASING RECORD

FORMATION	CONTENT	FROM	TO	SIZE	PUT IN	PULLED OUT
				8 5/8"	330	None
				4 1/2"	2890	1800

Describe in detail the manner in which the well was plugged, indicating where the mud fluid
was placed and the method or methods used in introducing it into the hold. If cement or other
plugs were used, state the character of same and depth placed, from _____ feet to
_____ feet for each plug set.

Sand from 2300' to 2230'
4 sacks cement from 2232' to 2200'
Ripped at 1800' Pulled 4 1/2" and layed down

Wooden bridge at 330'
Rock from 330' to 320'
6 yards of ready mix

RECEIVED
STATE CORPORATION COMMISSION

OCT 28 1977
10-28-77
CONSERVATION DIVISION
Wichita, Kansas

(If additional description is necessary, use BACK of this sheet)

Name of Plugging Contractor Clarke Corporation


STATE OF KANSAS COUNTY OF SEWARD, ss.
RALPH HAMMOCK (employee of owner) or (owner or operator)

of the above-described well, being first duly sworn on oath, says: That I have knowledge of
the facts, statements, and matters herein contained and the log of the above-described well
as filed and that the same are true and correct. So help me God.

(Signature) Ralph Hammock
Box 1507 LIBERAL KS. 67901
(Address)

SUBSCRIBED AND SWORN TO before me this 27TH day of OCTOBER, 19 77.

Patricia A. Pennington
Notary Public.

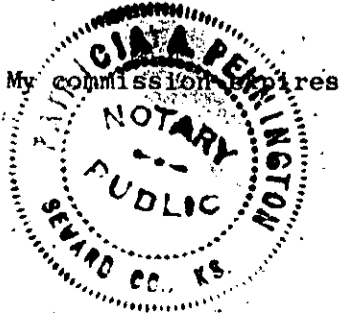

PATRICIA A. PENNINGTON