


WELL PLUGGING RECORD

Give All Information Completely
Make Required Affidavit
Mail or Deliver Report to:
Conservation Division
State Corporation Commission
211 No. Broadway
Wichita, Kansas

NORTH

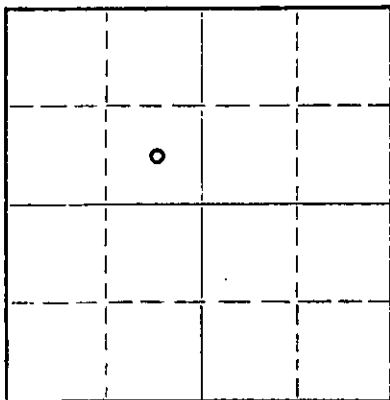

Locate well correctly on above
Section Plat

Ness County. Sec. 13 Twp. 20 Rge. 22 (E) W (W)

Location as "NE/CNW/SW" or footage from lines C SE NW

Lease Owner Sinclair Oil & Gas Company

Lease Name Anna Hoffman Well No. 1

Office Address Route # 1 - Great Bend, Kansas 67530

Character of Well (completed as Oil, Gas or Dry Hole) Dry Hole

Date well completed September 11, 19 64

Application for plugging filed September 12, 19 64

Application for plugging approved September 15, 19 64

Plugging commenced September 11, 19 64

Plugging completed September 11, 19 64

Reason for abandonment of well or producing formation Dry Hole

If a producing well is abandoned, date of last production _____ 19 _____

Was permission obtained from the Conservation Division or its agents before plugging was commenced? Yes

Name of Conservation Agent who supervised plugging of this well Mr. Eldon Petty

Producing formation _____ Depth to top _____ Bottom _____ Total Depth of Well 4493 Feet

Show depth and thickness of all water, oil and gas formations.

OIL, GAS OR WATER RECORDS

CASING RECORD

FORMATION	CONTENT	FROM	TO	SIZE	PUT IN	PULLED OUT
Mississippi Chat	Water	4414'	4458'	8 5/8"	465'	None

Describe in detail the manner in which the well was plugged, indicating where the mud fluid was placed and the method or methods used in introducing it into the hole. If cement or other plugs were used, state the character of same and depth placed, from _____ feet to _____ feet for each plug set.

Plugged and abandoned with mud from 4493' (T.D.) to 450'. Set 8-5/8" O.D. rubber plug @ 450'. Spotted mud from 450' to 240'. Spotted 20 sacks cement plug @ 240'. Spotted mud from 240' to 40'. Capped with 20 sacks cement. Plugged and abandoned as per State Plugging Agent's instructions, Mr. Eldon Petty, Hays, Kansas 9-11-64.

RECEIVED
STATE CORPORATION COMMISSION

SEP 27 1964
9-21-64
CONSERVATION DIVISION
WICHITA, KANSAS

(If additional description is necessary, use BACK of this sheet)

Name of Plugging Contractor Rains & Williamson Oil Company

Address 1425 Wichita Plaza Building - Wichita, Kansas 67202

STATE OF Kansas, COUNTY OF Barton, ss. J. F. Donham

(employee of owner) or (owner or operator) of the above-described well, being first duly sworn on oath, says: That I have knowledge of the facts, statements, and matters herein contained and the log of the above-described well as filed and that the same are true and correct. So help me God.

(Signature) J. F. Donham

Route # 1 - Great Bend, Kansas 67530
(Address)

SUBSCRIBED AND SWORN to before me this 18th day of September, 1964

My Commission Expires July 12, 1967
My commission expires _____

Fred E. Vobornik
Notary Public.

15-135-00329-0000

ROTARY DRILLING LOG

OPERATOR: Sinclair Oil & Gas Company
 No. 1 Anna Hoffman
 Approx. C SE NW
 Section 13-20S-22W
 Hodgeman County, Kansas
 NESS

CONTRACTOR: Rains & Williamson
 Oil Co.
 COMMENCED: 8-29-64
 COMPLETED: 9-12-64
 REMARKS: Set 8-5/8" surface pipe
 @ 465.89' with 250 sacks
 common cement, 2% calcium
 chloride.

FORMATIONS

Post Rock	70'
Shale & Shells	255'
Shale	625'
Red Bed & Shale	960'
Sand	1150'
Shale & Sand	1345'
Shale	1440'
Anhydrite	1480'
Shale & Lime Streaks	2461'
Shale & Lime	2551'
Lime	2735'
Lime & Shale	3084'
Shale & Lime	3625'
Lime (chaiky) & Shale	3755'
Lime & Shale	3910'
Lime	4395'
Cherty Lime	4413'
Lime	4440'
Lime & Chert	4493'
Rotary Total Depth (D&A)	4493'

RECEIVED
 STATE CORPORATION COMMISSION
 SEP 21 1964
 CONSERVATION DIVISION
 Wichita, Kansas

We certify the above log is true and correct to the best of our knowledge and belief.

RAINS & WILLIAMSON OIL CO.

Wilson Rains
 Wilson Rains, Partner

Subscribed and sworn to before me, the Notary Public in and for the State of Kansas, County of Sedgwick, this 14th day of September, 1964.

My Commission Expires:
January 8, 1968

Shirley Keck
 Shirley Keck, Notary Public