

15-007-30356-0000


WELL PLUGGING RECORD

Give All Information Completely
Make Required Affidavit
Mail or Deliver Report to:
Conservation Division
State Corporation Commission
211 No. Broadway
Wichita, Kansas

Barber County, Sec. 17 Twp. 30S Rge. 14W (E) (W)

Location as "NE/CNW/SW" or footage from lines C NW SW
Lease Owner Leben Drilling, Inc. Etal
Lease Name Basye Well No. 1
Office Address Box 486, Great Bend, Kansas 67530
Character of Well (completed as Oil, Gas or Dry Hole) Dry hole
Date well completed 1-16-66 19
Application for plugging filed 1-16-66 19
Application for plugging approved 1-16-66 19
Plugging commenced 1-16-66 19
Plugging completed 1-16-66 19
Reason for abandonment of well or producing formation Dry Hole

NORTH

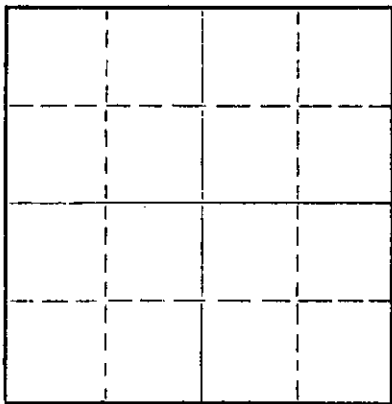

Locate well correctly on above
Section Plat

If a producing well is abandoned, date of last production 19
Was permission obtained from the Conservation Division or its agents before plugging was commenced? yes

Name of Conservation Agent who supervised plugging of this well Archie Elving, Pratt, Kansas 67124
Producing formation _____ Depth to top _____ Bottom _____ Total Depth of Well 4707 Feet
Show depth and thickness of all water, oil and gas formations.

OIL, GAS OR WATER RECORDS

CASING RECORD

FORMATION	CONTENT	FROM	TO	SIZE	PUT IN	PULLED OUT
				8 5/8"	307'	none

Describe in detail the manner in which the well was plugged, indicating where the mud fluid was placed and the method or methods used in introducing it into the hole. If cement or other plugs were used, state the character of same and depth placed, from _____ feet to _____ feet for each plug set.

Mud to 275', set plug, 1/2 sk. hulls and 25 sks. cement
Mud to 40', set plug, 1/2 sk. hulls and 10 sks. cement
2 sks. in rathole

RECEIVED
STATE CORPORATION COMMISSION

JAN 20 1966
1-20-66

(If additional description is necessary, use BACK of this sheet)

Name of Plugging Contractor Leben Drilling, Inc.
Address Box 486, Great Bend, Kansas 67530

STATE OF KANSAS, COUNTY OF BARTON, ss.
Leslie Kite

(employee of owner) or (owner or operator) of the above-described well, being first duly sworn on oath, says: That I have knowledge of the facts, statements, and matters herein contained and the log of the above-described well as filed and that the same are true and correct. So help me God.

(Signature) Leslie Kite

P. O. Box 486, Great Bend, Kansas
(Address)

SUBSCRIBED AND SWORN TO before me this 18th day of January, 19 66.

My commission expires April 1, 1967

Ulanda Nichols
Ulanda Nichols Notary Public.

DRILLER'S LOG

COMPANY: Leben Drilling, Inc. Etal
 CONTRACTOR: LEBEN DRILLING, INC.
 FARM: BASYE #1
 LOCATION: C NW SW Sec. 17-30S-14W
 BARBER COUNTY, KANSAS
 COMMENCED: 1-4-66
 COMPLETED: 1-16-66

0	60	Surface soil, sand
60	1156	Redbed
1156	1710	Shale, shells
1710	2100	Shale, lime
2100	2770	Lime, shale
2770	3590	Shale, lime
3590	3995	Lime, shale
3995	4555	Lime
4555	4575	Lime, chert
4575	4600	Chert, lime
4600	4610	Lime, sand
4610	4624	Shale, sand
4624	4626	Sand
4626	4640	Sand, shale
4640	4686	Shale, lime
4686	4707	Lime
	<u>4707</u>	<u>RTD - D. & A.</u>

RECEIVED
 STATE CORPORATION COMMISSION
 JAN 20 1966
 1-20-66
 CONSERVATION DIVISION
 Topeka, Kansas

Set 8 5/8" used surface casing @ 307' with 275 sacks Common 2% Gel
 2% cc

I, Leslie Kite, do hereby certify that the above and foregoing is a true and correct copy of the log of the Basye #1 well, located C NW SW of Section 17, Township 30 South, Range 14 West, Barber County, Kansas, as reflected by the records of Leben Drilling, Inc.

Leslie Kite
 Leslie Kite

STATE OF KANSAS)
) SS
 COUNTY OF BARTON)

Subscribed and sworn to and before me, a Notary Public, in and for Barton County, Kansas, this 18th day of January, 1966.

Ulanda Nichols
 Ulanda Nichols

My Commission Expires:
 April 1, 1967