


WELL PLUGGING RECORD

Give All Information Completely
The Required Affidavit
File or Deliver Report to:
Conservation Division
State Corporation Commission
211 No. Broadway
Wichita, Kansas

NORTH

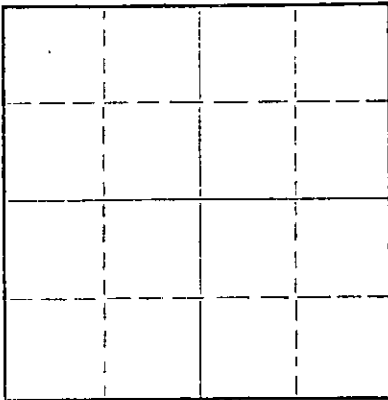

Locate well correctly on above
Section Plat

Barber County, Sec. 19 Twp 30S Rge 11W (E) (W)
Location as "NE/CNW/SW" or footage from lines 8th NE NE
Lease Owner Thompson & Bear
Lease Name Eads Well No 2
Office Address 335 Union Center Wichita, Kansas
Character of Well (completed as Oil, Gas or Dry Hole) Oil
Date well completed 19
Application for plugging filed February 6, 1963 19
Application for plugging approved February 7, 1963 19
Plugging commenced February 20, 1963 19
Plugging completed February 24, 1963 19
Reason for abandonment of well or producing formation Dry

If a producing well is abandoned, date of last production 19
Was permission obtained from the Conservation Division or its agents before plugging was commenced? Yes

Name of Conservation Agent who supervised plugging of this well Archie Elving
Producing formation Depth to top Bottom Total Depth of Well PB 4513 Feet
Show depth and thickness of all water, oil and gas formations.

OIL, GAS OR WATER RECORDS

CASING RECORD

FORMATION	CONTENT	FROM	TO	SIZE	PUT IN	PULLED OUT
				8 5/8	264	none
				5 1/2	none	4060

Describe in detail the manner in which the well was plugged, indicating where the mud fluid was placed and the method or methods used in introducing it into the hole. If cement or other plugs were used, state the character of same and depth placed, from feet to feet for each plug set.

Moved on and cleaned out cellar, measured T.D. and sanded to 4515'. Dumped 4 sx. cement.
Shot @ 4035' and started pulling pipe.
Pulled pipe.
Pulled rest of pipe.
Plugged well @ 200' and built 18' rock bridge. Dumped 20 sx. cement and filled hole and rock bridge. Mudded to 40' and built 10' rock bridge. Capped well with 10 sx. cement

RECEIVED
STATE CORPORATION COMMISSION

MAR 20 1963
3-20-63

CONSERVATION DIVISION
Wichita, Kansas

(If additional description is necessary, use BACK of this sheet)

Name of Plugging Contractor Forbes Casing Pulling, Inc.
Address Box 221 Great Bend, Kansas

STATE OF Kansas, COUNTY OF Barton, ss.
J. O. Forbes (employee of owner) or (owner or operator) of the above-described well, being first duly sworn on oath, says: That I have knowledge of the facts, statements, and matters herein contained and the log of the above-described well as filed and that the same are true and correct. So help me God.

(Signature) J. O. Forbes
Box 221 Great Bend, Kansas
(Address)

SUBSCRIBED AND SWORN TO before me this 1st day of March, 1963

My commission expires July 23, 1966

Carolyn Herren
Notary Public.

ROTARY DRILLING LOG

OPERATOR: H. D. Thompson & M. F. Bear
 SW NE NE Sec. 4-30-14W,
 Barber County, Kansas
EADS NO. 2

CONTRACTOR: Prime Drilling Company
 COMM: 5/7/59
 COMP: 5/23/59

Remarks: Set 8-5/8" surface casing
 at 264' cemented with 225
 sacks HA 500 Pozmix

Formations:

Clay	30'
Sand	170'
Red Bed & Shells	908'
Anhydrite	923'
Shale & Shells	1475'
Shale & Lime	2043'
Lime	2460'
Shale & Lime	2580'
Lime & Shale	2665'
Lime	2745'
Lime & Shale	2945'
Shale & Lime	3055'
Lime & Shale	3495'
Lime	3874'
Shale & Lime	4004'
Lime	4495'
Lime & Chert	4552'
Sand	4558'
Rotary Total Depth	4558'

Set 5-1/2" production casing at 4549'
 cemented with 75 sacks Pozmix.

We certify the above log is true
 and correct to the best of our
 knowledge and belief.

PRIME DRILLING COMPANY

R. R. McNicol
 R. R. McNicol

RECEIVED
 STATE CORPORATION COMMISSION

MAR 20 1963
 3-20-63
 CONSERVATION DIVISION
 Wichita, Kansas