


Give All Information Completely
Make Required Affidavit
Mail or Deliver Report to:
Conservation Division
State Corporation Commission
211 No. Broadway
Wichita, Kansas

WELL PLUGGING RECORD

NORTH

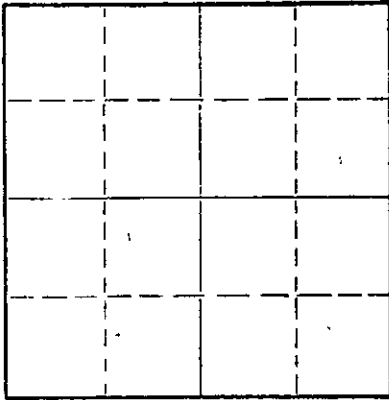

Locate well correctly on above
Section Plat

Barber County. Sec. 4 Twp. 30S Rgd. 4W (E) (W)
Location as "NE/CNW/SW" or footage from lines C NW NW
Lease Owner Skelly Oil Co.
Lease Name Eubank Well No. 1
Office Address 1020 N. Main, Hutchinson, Kansas
Character of Well (completed as Oil, Gas or Dry Hole) Dry Hole
Date well completed 12-17-62 19
Application for plugging filed 12-17-62 19
Application for plugging approved 12-17-62 19
Plugging commenced 12-17-62 19
Plugging completed 12-17-62 19
Reason for abandonment of well or producing formation Dry Hole

If a producing well is abandoned, date of last production _____ 19____
Was permission obtained from the Conservation Division or its agents before plugging was commenced? yes

Name of Conservation Agent who supervised plugging of this well Mr. Elving, Pratt, Kansas
Producing formation _____ Depth to top _____ Bottom _____ Total Depth of Well 4740 Feet
Show depth and thickness of all water, oil and gas formations.

OIL, GAS OR WATER RECORDS

CASING RECORD

FORMATION	CONTENT	FROM	TO	SIZE	PUT IN	PULLED OUT
				8 5/8"	785'	

Describe in detail the manner in which the well was plugged, indicating where the mud fluid was placed and the method or methods used in introducing it into the hole. If cement or other plugs were used, state the character of same and depth placed, from _____ feet to _____ feet for each plug set.

Spot 50 sacks of cement - lay down drill pipe to 300'. Set bridge plug - Cemented with 20 sacks of cement.
Lay down rest of drill pipe - filled hole to 35' with mud. Set bridge plug @ 35' Cemented with 10 sacks of cement.

RECEIVED
STATE CORPORATION COMMISSION

DEC 21 1962

12-21-62

CONSERVATION DIVISION
Wichita, Kansas

(If additional description is necessary, use BACK of this sheet)

Name of Plugging Contractor Leben Drilling, Inc.
Address P. O. Box 486, Great Bend, Kansas

STATE OF KANSAS, COUNTY OF BARTON, ss.
Byron Johnson (employee of owner) or (owner or operator) of the above-described well, being first duly sworn on oath, says: That I have knowledge of the facts, statements, and matters herein contained and the log of the above-described well as filed and that the same are true and correct. So help me God.

(Signature) Byron Johnson
P. O. Box 486, Great Bend, Kansas
(Address)

SUBSCRIBED AND SWORN to before me this 19th day of December, 1962

My commission expires April 1, 1963
Ulanda Nichols Notary Public.



DRILLER'S LOG

COMPANY: Skelly Oil Company
 CONTRACTOR: LEBEN DRILLING, INC.
 FARM: EUBANK #1
 LOCATION: C NW NW Sec. 4-30S-14W
 BARBER COUNTY, KANSAS
 COMMENCED: 11-30-62
 COMPLETED: 12-17-62

0	60	Clay
60	90	Shale
90	140	Sand
140	510	Redbed & Shale
510	600	Shale & Redbed
600	1950	Shale & Shells
1950	2155	Lime & Shale
2155	2740	Lime
2740	2915	Lime & Shale
2915	3060	Shale & Lime
3060	3275	Lime
3275	3535	Lime & Shale
3535	4593	Lime
4593	4597	Sand
4597	4610	Simpson Sand
4610	4640	Sand & Shale
4640	4680	Shale & Lime
4680	4740	Lime
	<u>4740</u>	<u>Rotary Total Depth - D. & A.</u>

RECEIVED
 STATE CORPORATION COMMISSION
 DEC 21 1962
 12-21-62
 CONSERVATION DIVISION
 Wichita, Kansas

Set 8 5/8" 28# Surface casing @ 785' Cemented with 200 sacks of Posmix with 2% c.c. and 225 sacks of HA5 by Halliburton.

I, Byron Johnson, do hereby certify that the above and foregoing is a true and correct copy of the log of the Eubank #1, located C NW NW of Section 4, Township 30 South, Range 4 West, Barber County, Kansas, as reflected by the files of Leben Drilling, Inc.

Byron Johnson

Byron Johnson

STATE OF KANSAS)
 COUNTY OF BARTON) SS

Subscribed and sworn to before me, a Notary Public, in and for Barton County, Kansas, this 19th day of December, 1962.

Ulanda Nichols

Ulanda Nichols, Notary Public

My Commission Expires:
 April 1, 1963