


See All Information Completely  
See Required Affidavit  
File or Deliver Report to:  
Conservation Division  
State Corporation Commission  
211 No. Broadway  
Wichita, Kansas

WELL PLUGGING RECORD

Barber County, Sec. 11 Twp. 30S Rge. 14W (E) (W)

Location as "NE/CNW/SW" or footage from lines NE NE NE  
Lease Owner Thompson & Bear  
Lease Name Eads Well No. 1  
Office Address 335 Union Center Wichita, Kansas  
Character of Well (completed as Oil, Gas or Dry Hole) Oil  
Date well completed 19  
Application for plugging filed February 6, 1963 19  
Application for plugging approved February 7, 1963 19  
Plugging commenced February 25, 1963 19  
Plugging completed February 28, 1963 19  
Reason for abandonment of well or producing formation Dry

NORTH

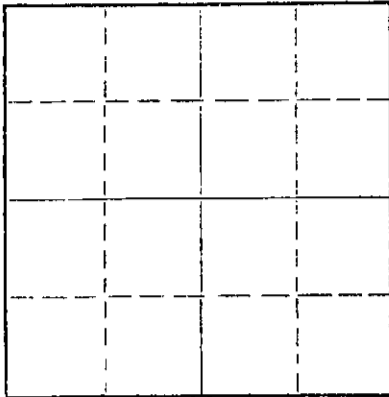

Locate well correctly on above  
Section Plat

If a producing well is abandoned, date of last production 19  
Was permission obtained from the Conservation Division or its agents before plugging was com-  
menced? Yes

Name of Conservation Agent who supervised plugging of this well Archie Elving  
Producing formation Depth to top Bottom Total Depth of Well 4570 Feet  
Show depth and thickness of all water, oil and gas formations.

OIL, GAS OR WATER RECORDS

CASING RECORD

FORMATION	CONTENT	FROM	TO	SIZE	PUT IN	PULLED OUT
				8 5/8	316	none
				5 1/2	none	4068

Describe in detail the manner in which the well was plugged, indicating where the mud fluid was placed and the method or methods used in introducing it into the hole. If cement or other plugs were used, state the character of same and depth placed, from feet to feet for each plug set.

Moved on and cleaned out cellar, measured T.D. and rigged up jacks. Sanded to 4560' and dumped 5 sx. cement. Shot @ 4034' and started pulling pipe. Pulled rest of pipe. Plugged @ 200' and built 18' rock bridge, dumped 20 sx. cement and filled hole and rock bridge. Mudded to 40' and built 10' rock bridge. Capped well with 10 sx. cement.

RECEIVED  
STATE CORPORATION COMMISSION

MAR 20 1963  
3-20-63

CONSERVATION DIVISION  
Wichita, Kansas

(If additional description is necessary, use BACK of this sheet)

Name of Plugging Contractor Forbes Casing Pulling, Inc.  
Address Box 221 Great Bend, Kansas

STATE OF Kansas, COUNTY OF Barton, ss.  
J. O. Forbes (employee of owner) or (owner or operator) of the above-described well, being first duly sworn on oath, says: That I have knowledge of the facts, statements, and matters herein contained and the log of the above-described well as filed and that the same are true and correct. So help me God.

(Signature) J. O. Forbes  
Box 221 Great Bend, Kansas (Address)

SUBSCRIBED AND SWORN TO before me this 1st day of March, 19 63

Caryn Herron  
Notary Public.

My commission expires July 23, 1966

# WELL LOG

COMPANY Thompson and Bear

SEC. 4 T. 30S R. 14W

FARM Eads

NO. 1

LOC. NE $\frac{1}{4}$ NE $\frac{1}{4}$ NE $\frac{1}{4}$

TOTAL DEPTH 4570'

COUNTY Barber  
KANSAS


COMM. November 10, 1958

COMP. November 26, 1958

SHOT OR TREATED

CONTRACTOR Lewis Drilling Company

ISSUED

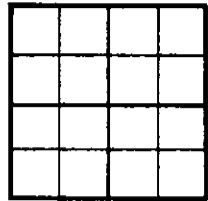

CASINO

20 10  
15 X 8-5/8" - 331'  
12 6  
13 X 5 1/2" - 4561'

ELEVATION 1987 KB  
1977 GL

PRODUCTION

FIGURES INDICATE BOTTOM OF FORMATIONS

0 - 50 Clay  
50 - 150 Sand  
150 - 490 Red Bed  
490 - 597 Red Bed & Shale  
597 - 730 Shale & Shells  
730 - 800 Anhydrite  
800 - 1960 Shale & Shells  
1960 - 2114 Lime Stringers & Shale  
2114 - 2440 Lime & Shale  
2440 - 2520 Shale  
2520 - 2655 Shale & Lime Streaks  
2655 - 2810 Lime & Shale  
2810 - 2901 Shale  
2901 - 3115 Shale & Shells  
3115 - 3595 Lime & Shale  
3595 - 3675 Lime  
3675 - 3745 Lime & Chalk  
3745 - 3779 Lime & Shale  
3779 - 3885 Shale  
3885 - 3988 Lime & Shale  
3988 - 4012 Shale  
4012 - 4014 Brown Lime  
4014 - 4355 Lime  
4355 - 4410 Lime & Shale  
4410 - 4515 Lime  
4515 - 4561 Lime & Chert  
4561 - 4570 Simpson  
4570 - Total Depth

Geologic Tops

Heebner Shale 3842  
Douglas 3872  
Brown Lime 4010  
Lansing 4026  
Drum 4201  
B/Kansas City 4396  
Conglomerate 4496  
Viola Chert 4510  
Simpson Shale 4552  
Simpson Dolomite 4556  
Simpson Sand 4560

**RECEIVED**  
STATE CORPORATION COMMISSION

MAR 20 1963  
3-20-63  
CONSERVATION DIVISION  
Wichita, Kansas

State of Kansas }  
County of Sedgwick } SS:

I, William J. Duckett of the Lewis Drilling Company  
upon oath state that the above and foregoing is a true and correct copy of the log of the Eads #1 well.

*William J. Duckett*

Subscribed and sworn to before me this 9th day of December 1958

Commission Expires: August 20, 1960

*A. R. Derrington*  
NOTARY PUBLIC  
(A. R. Derrington)