


15-007-00309-0000

STATE OF KANSAS
STATE CORPORATION COMMISSION

WELL PLUGGING RECORD

Give All Information Completely
Make Required Affidavit
Mail or Deliver Report to:
Conservation Division
State Corporation Commission
800 Bittling Building
Wichita, Kansas

NORTH

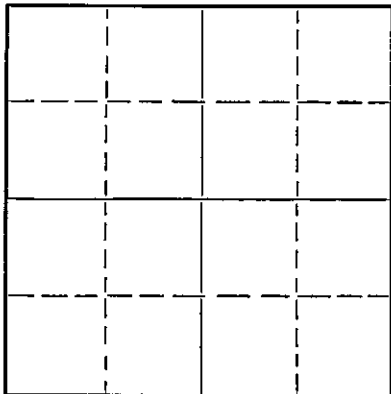

Locate well correctly on above
Section Plat

Barber County, Sec. 4 Twp. 30 Rge. 14 (E) (W)

Location as "NE/CNW $\frac{1}{4}$ SW $\frac{1}{4}$ " or footage from lines NE NE NW

Lease Owner National Cooperative Refinery Association

Lease Name Eubank Well No. 1

Office Address 820 Union National Bank Building

Character of Well (completed as Oil, Gas or Dry Hole) Dry Hole

Date well completed August 7, 19 51

Application for plugging filed August 7, 19 51

Application for plugging approved August 7, 19 51

Plugging commenced August 16, 19 51

Plugging completed August 16, 19 51

Reason for abandonment of well or producing formation Dry

If a producing well is abandoned, date of last production 19

Was permission obtained from the Conservation Division or its agents before plugging was commenced? Yes

Name of Conservation Agent who supervised plugging of this well Mr. C. D. Stough

Producing formation Depth to top Bottom Total Depth of Well 4675 Feet

Show depth and thickness of all water, oil and gas formations.

OIL, GAS OR WATER RECORDS

CASING RECORD

Formation	Content	From	To	Size	Put In	Pulled Out
				8-5/8	785'	Cemented

Describe in detail the manner in which the well was plugged, indicating where the mud fluid was placed and the method or methods used in introducing it into the hole. If cement or other plugs were used, state the character of same and depth placed, from feet to feet for each plug set.

Filled hole with rock and cement to 4455'. Filled hole with heavy mud to 260', bridged with rock, dumped 15 sacks cement. Filled hole with heavy mud to 35', bridged with rock, dumped 10 sacks cement on up to base of cellar.

8-21-51

(If additional description is necessary, use BACK of this sheet)

Correspondence regarding this well should be addressed to National Cooperative Refinery Association
Address 820 Union National Bank Building

STATE OF Kansas, COUNTY OF Sedgwick, ss.

W. Jean La Coss (employee of owner) or (owner or operator) of the above-described well, being first duly sworn on oath, says: That I have knowledge of the facts, statements, and matters herein contained and the log of the above-described well as filed and that the same are true and correct. So help me God.

(Signature) W. Jean La Coss

820 Union National Bank Building
(Address)

SUBSCRIBED AND SWORN TO before me this 20 day of August, 1951

I. A. Lange

I. A. Lange Notary Public.

My commission expires February 20, 1953

23-5091-s 8-50-10M

PLUGGING
FILE SEC 1 T 30 R 14 W
BOOK PAGE 100 LINE 38

The National Cooperative Refinery Association Location NE NE NW Section 4
 Eubank Well #1 T30S-R14W, Barber County, Kansas.
 Comm 5/26/51 CASING RECORD
 Comp 8/6/51 8 5/8" Casing at 785 Feet
 Contractor R. C. Patton Co., Cemented with 400 Sacks Cement
 Total Depth 4675 Feet. 5 1/2" Casing at 4672 1/2 Feet
 Cemented with 100 Sacks.

Clay & Gyp	25
Calv & Sand	150
Red Shale	215
Red Bed & Shells	560
Red Bed & Shale	767
Red Bed	880
Anhydrite	820
Red Bed & Shale	860
Shale & Shells	1070
Sahel & Salt	1150
Shale & Shells	1590
Lime & Shale	2080
Shale & Anhydrite	2135
Lime	2405
Lime & Shale	2455
Lime	2520
Lime & Shale	2840
Shale & Shells	2950
Lime & Shale	3100
Shale	3210
Lime	3315
Lime & Shale	3410
Lime	3845
Shale & Lime	3920
Sand	3940
Lime	4450
Broken Lime & Shale	4482
Lime & Shale	4507
Lime	4528
Lime & Chert	4555
Lime	4570
Sand	4572
Cored	4576
Sand & Shale	4656
Shale	4674
Lime	4675
Total Depth	4675

STATE OF Kansas COUNTY OF Sedgewick ss,

I, the undersigned, being duly sworn, on oath state that the above statement and log is a true and correct record and log of the well drilled at the location above described.

R. C. PATTON CO.,

By R. C. Patton

Subscribed and sworn to before me this 9th day of August 1951

J. P. Hendrich
 Notary Public.

My Commission Expires Oct. 4th, 1952

STATE OF KANSAS
 8-15-51
 AUG 15 1951

CONSERVATION DIVISION
 Wichita, Kansas

PLUGGING
 FILE SEC 4-T-3-R14W
 BOOK PAGE 100 LINE 38