

STATE OF KANSAS  
STATE CORPORATION COMMISSION


WELL PLUGGING RECORD

Give All Information Completely  
Make Required Affidavit  
Mail or Deliver Report to:  
Conservation Division  
State Corporation Commission  
800 Bitting Building  
Wichita, Kansas

Barber County, Sec. 4 Twp. 30S Rge. 14 (E) (W)

Location as "NE/CNW/SW" or footage from lines NW NW SE  
Lease Owner National Cooperative Refinery Association  
Lease Name Shriver Well No. 1  
Office Address 305 Rule Building, Wichita, Kansas  
Character of Well (completed as Oil, Gas or Dry Hole) Dry Hole  
Date well completed June 1, 19 55  
Application for plugging filed June 1, 19 55  
Application for plugging approved June 2, 19 55  
Plugging commenced June 1, 19 55  
Plugging completed June 1, 19 55  
Reason for abandonment of well or producing formation Dry Hole

NORTH

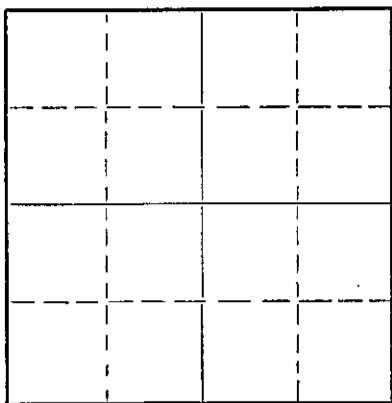

Locate well correctly on above  
Section Plat

If a producing well is abandoned, date of last production 19  
Was permission obtained from the Conservation Division or its agents before plugging was commenced? yes

Name of Conservation Agent who supervised plugging of this well Warren Horner  
Producing formation \_\_\_\_\_ Depth to top \_\_\_\_\_ Bottom \_\_\_\_\_ Total Depth of Well 4695 Feet  
Show depth and thickness of all water, oil and gas formations.

OIL, GAS OR WATER RECORDS

CASING RECORD

FORMATION	CONTENT	FROM	TO	SIZE	PUT IN	PULLED OUT
				8 5/8"	408'	None-cemented

Describe in detail the manner in which the well was plugged, indicating where the mud fluid was placed and the method or methods used in introducing it into the hole. If cement or other plugs were used, state the character of same and depth placed, from \_\_\_\_\_ feet to \_\_\_\_\_ feet for each plug set.

Filled hole with heavy mud to 400', dumped 1/3 sax hulls. Set Halliburton plug, mixed and dumped 25 sax cement thru drill pipe. Mudded hole to 35', dumped 1/3 sax hulls, set Halliburton plug. Dumped 10 sax cement on up to base of cellar.

(If additional description is necessary, use BACK of this sheet)

Name of Plugging Contractor Musgrove Petroleum, Inc.  
Address 518 Petroleum Building, Wichita, Kansas

STATE OF Kansas, COUNTY OF Sedgwick, ss.  
C. R. Sears (employee of owner) or (owner or operator) of the above-described well, being first duly sworn on oath, says: That I have knowledge of the facts, statements, and matters herein contained and the log of the above-described well as filed and that the same are true and correct. So help me God.


(Signature) C. R. Sears  
305 Rule Building, Wichita, Kansas  
(Address)

SUBSCRIBED AND SWORN TO before me this 6th day of June, 19 55

My commission expires June 30, 1958.

C. Orville May  
Notary Public

24-2675-5 2-52-20M

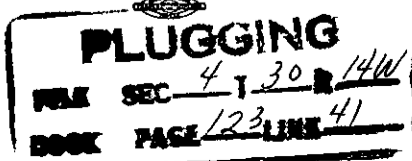

JUN 7 - 1955  
6-7-55  
CONSERVATION DIVISION  
Wichita, Kansas

CONTRACTOR'S WELL LOG

COMPANY:	N. C. R. A.
CONTRACTOR:	Musgrove Petroleum Corporation
FARM:	SHRIVER #1
LOCATION:	NW NW SE Section 4-30-14 Barber County, Kansas
COMMENCED:	May 13, 1955
COMPLETED:	June 1, 1955

0	.85	Surface soil
85	225	Sand
225	400	Sand, shale & shells
400	560	Red bed & red shale
560	805	Red shale & shells
805	820	Anhydrite
820	1450	Sand, shale & lime streaks
1450	1700	Shale & shells
1700	3965	Shale & lime
3965	4025	Lime
4025	4480	Lime & shale
4480	4517	Lime
4517	4550	Chert & lime
4550	4575	Cherty lime
4575	4593	Simpson sand
4593	4603	Simpson lime
4603	4632	Simpson sand
4632	4674	Shale & lime
4674	4695	Arbuckle
	4695	Rotary Total Depth

Set 8-5/8" surface casing at 408' with 400 sacks cement, 2% calcium chloride

Dry and Abandoned

STATE OF KANSAS )  
 ) SS  
 COUNTY OF SEDGWICK )

I, GORDON L. KOELLING, do hereby certify that the above and foregoing is a true and correct copy of the log of the SHRIVER #1, NW NW SE Section 4-30-14, Barber County, Kansas, as reflected by the files of the Musgrove Petroleum Corporation.

MUSGROVE PETROLEUM CORPORATION

BY Gordon L. Koelling  
 Secretary/Treasurer

Subscribed and sworn to before me, a Notary Public, in and for Sedgwick County, Kansas, this 3rd day of June, 1955.

Alma E. Rose  
 Notary Public

My commission expires July 16, 1955

RECEIVED  
 6-7-55

PLUGGING  
