

15-007-00037-0000

STATE OF KANSAS  
STATE CORPORATION COMMISSION


Give All Information Completely  
Make Required Affidavit  
Mail or Deliver Report to:  
Conservation Division  
State Corporation Commission  
211 No. Broadway  
Wichita, Kansas

WELL PLUGGING RECORD

BARBER County, Sec. 4 Twp. 30S Rge. 14 (X) W (W)

Location as "NE/CNW/SW" or footage from lines C-NE, SE  
Lease Owner THOMPSON & BEAR  
Lease Name SHRIVER Well No. 1  
Office Address 335 UNION CENTER, WICHITA 2, KANSAS  
Character of Well (completed as Oil, Gas or Dry Hole) D & A  
Date well completed July 12, 19 61  
Application for plugging filed July 12, 19 61  
Application for plugging approved July 12, 19 61  
Plugging commenced July 12, 19 61  
Plugging completed July 12, 19 61  
Reason for abandonment of well or producing formation No productive zone

NORTH

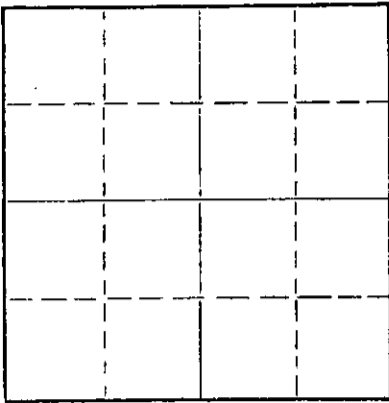

Locate well correctly on above  
Section Plat

If a producing well is abandoned, date of last production 19  
Was permission obtained from the Conservation Division or its agents before plugging was com-  
menced? Yes

Name of Conservation Agent who supervised plugging of this well Fred Hampel  
Producing formation Depth to top Bottom Total Depth of Well 4651 Feet  
Show depth and thickness of all water, oil and gas formations.

OIL, GAS OR WATER RECORDS

CASING RECORD

FORMATION	CONTENT	FROM	TO	SIZE	PUT IN	PULLED OUT
				8-5/8"	300'	

Describe in detail the manner in which the well was plugged, indicating where the mud fluid was placed and the method or methods used in introducing it into the hole. If cement or other plugs were used, state the character of same and depth placed, from feet to feet for each plug set.

Gunned up pits forming heavy mud, filled hole up to 290', pushed wooden plug with 1/4 sx. hulls to 290', capped with 15 sx. cement through drill pipe.  
Filled hole up to 35', with heavy mud, pushed plug with 1/4 sx. hulls to 35', capped with 10 sx. cement up to base of well cellar.

RECEIVED  
STATE CORPORATION COMMISSION

JUL 24 1961  
7-24-61  
CONSERVATION DIVISION  
Wichita, Kansas

(If additional description is necessary, use BACK of this sheet)

Name of Plugging Contractor Garvey Drilling Company  
Address Route #2, Great Bend, Kansas

STATE OF Kansas, COUNTY OF Barton, ss.  
Verne A. Morris (employee of owner) of the above-described well, being first duly sworn on oath, says: That I have knowledge of the facts, statements, and matters herein contained and the log of the above-described well as filed and that the same are true and correct. So help me God.

(Signature) Verne A. Morris  
Route #2, Great Bend, Kansas  
(Address)

SUBSCRIBED AND SWORN TO before me this 21st day of July, 19 61

My commission expires November 12, 1962

Notary Public.

15-007-00037-0000  
WELL LOG

COMPANY THOMPSON & BEAR

SEC. 4 T30S R. 14W

FARM SHRIVER

NO. 1

LOC. C-NE, SE


TOTAL DEPTH 4651'

COUNTY BARBER CO., KANSAS

COMM. June 28, 1961

COMP. July 12, 1961

CONTRACTOR GARVEY DRILLING COMPANY

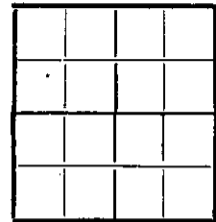

CASING 8-5/8" @ 300' w/225 sax.

ELEVATION 1963' DF

PRODUCTION D & A

FIGURES INDICATE BOTTOM OF FORMATIONS

125	Surface clay & sand
600	Red bed
790	Red bed & shale
815	Anhydrite
849	Shale
1950	Shale & shells
1980	Shale w/lime streaks
2000	Shale
2240	Lime
2265	Shale & lime
2455	Lime
2585	Lime & shale
2850	Shale & lime
2925	Lime & shale
3365	Shale & lime
3443	Lime
3545	Shale & lime
3720	Lime & shale
3020	Broken lime
3920	Lime
4035	Lime & shale
4484	Lime
4530	Cherty lime
4546	Lime
4557	Cherty lime & sand
4582	Sand
4627	Shale & sand
4651	Shale & lime
4651	T. D.

**RECEIVED**  
STATE CORPORATION COMMISSION  
AUG 18 1961  
8-18-61  
CONSERVATION DIVISION  
Wichita, Kansas

State of KANSAS }  
County of BARTON } SS

I, VERNE A. MORRIS of GARVEY DRILLING COMPANY

upon oath state the above and foregoing is a true and correct copy of the log of the #1 SHRIVER well.

*Verne A. Morris*

Subscribed and sworn to before me this 21st day of July 19 61

My Commission Expires: November 12, 1962

*Notary Public*  
NOTARY PUBLIC