

15-007-21204-0000

STATE OF KANSAS
STATE CORPORATION COMMISSION

WELL PLUGGING RECORD

Give All Information Completely
Make Required Affidavit
Mail or Deliver Report to
Conservation Division
State Corporation Comm.
245 North Water
Wichita, KS 67202

Barber County. Sec. 6 Twp. 30S Rge. 14 E W

Location as "NE/CNW $\frac{1}{2}$ SW $\frac{1}{2}$ " or footage from lines
C NE NW

Lease Owner Gould Oil, Inc.

Lease Name Weede #1 Well No. 1

Office Address 260 N. Rock Road

Character of Well (Completed as Oil, Gas or Dry Hole)
Dry Hole

Date Well completed 06-29 1981

Application for plugging filed 06-29 1981

Application for plugging approved 06-29- 1981


Plugging commenced 06-29 1981

Plugging completed 06-29 1981

Reason for abandonment of well or producing formation
Dry Hole

If a producing well is abandoned, date of last production
19

Was permission obtained from the Conservation Division or
its agents before plugging was commenced?

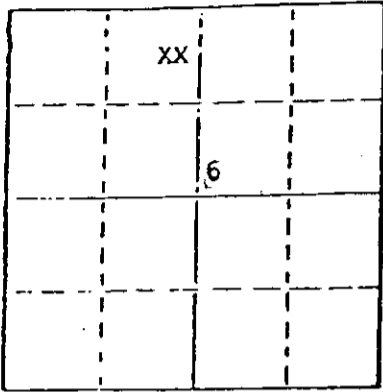

Locate well correctly on above
Section Plat

Name of Conservation Agent who supervised plugging of this well

Producing formation Depth to top Bottom Total Depth of Well 4746'

Show depth and thickness of all water, oil and gas formations.

OIL, GAS OR WATER RECORDS

CASING RECORD

FORMATION	CONTENT	FROM	TO	SIZE	PUT IN	PULLED OUT
				8 5/8	329	

Describe in detail the manner in which the well was plugged, indicating where the mud fluid was placed and the method or methods used in introducing it into the hold. If cement or other plugs were used, state the character of same and depth placed, from feet to feet for each plug set.

plugged at 7:45 a.m. on 06-29-81 with 50-50 pos, 4%gel 3%cc. 35 sacks at 520', 40 sacks at 330' 10 sacks at 40', 10 sacks in rathole, 5 sacks in mousehole.

RECEIVED

STATE CORPORATION COMMISSION

(If additional description is necessary, use BACK of this sheet)

Name of Plugging Contractor Cemented by Haliburton, Maurice Leslie state plugging

FILE - 91981
7-9-81
CONSERVATION DIVISION

STATE OF Kansas COUNTY OF Sedgwick

Wichita, Kansas
ss.

(employee) of owner) or (owner or operator) of the above-described well, being first duly sworn on oath, says: That I have knowledge of the facts, statements, and matters herein contained and the log of the above-described well is filed and that the same are true and correct. So help me God.

(Signature) John Weede
260 North Rock Road
(Address)

SUBSCRIBED AND SWORN TO before me this 8th day of July, 1981

Tammy L. Armstrong
Notary Public.

commission expires 7/2/85

