


STATE OF KANSAS
STATE CORPORATION COMMISSION

Give All Information Completely
Make Required Affidavit
Mail or Deliver Report to:
Conservation Division
State Corporation Commission
P. O. Box 17027
Wichita, Kansas 67217
NORTH

WELL PLUGGING RECORD

Ness County, Sec. 18 Twp. 20 Rge. 22 (E) W (W)
Location as "NE/CNWxSWx" or footage from lines 150' W of C SE NW
Lease Owner Pickrell Drlg. Co. ; Wichita, Ks. 67202
Lease Name Gross 'A' Well No. # 1
Office Address 705 Fourth National Bank Building
Character of Well (completed as Oil, Gas or Dry Hole) Oil
Date well completed April 30 1966
Application for plugging filed March 24 1972
Application for plugging approved March 24 1972
Plugging commenced April 25 1972
Plugging completed June 2 1972
Reason for abandonment of well or producing formation Well Depleted

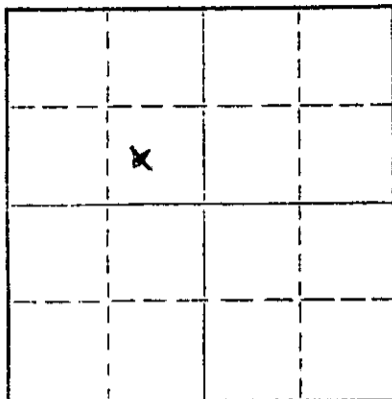

Locate well correctly on above
Section Plat

If a producing well is abandoned, date of last production February 24 1972
Was permission obtained from the Conservation Division or its agents before plugging was commenced? Yes

Name of Conservation Agent who supervised plugging of this well Leo Massey
Producing formation Mississippian Depth to top 4334 Bottom 4344 Total Depth of Well 4344 Feet
Show depth and thickness of all water, oil and gas formations.

OIL, GAS OR WATER RECORDS


CASING RECORD

FORMATION	CONTENT	FROM	TO	SIZE	PUT IN	PULLED OUT
				8 5/8"	247	None
				5 1/2"	4334	380

Describe in detail the manner in which the well was plugged, indicating where the mud fluid was placed and the method or methods used in introducing it into the hole. If cement or other plugs were used, state the character of same and depth placed, from _____ feet to _____ feet for each plug set.

April 25, 1972 Plugged off bottom, Dumped sand to 4000'. Mixed and dumped 5 sx of cement.

June 2, 1972 Plugged off top, Globe Oil Well Cementing Co. mixed and pumped down 8 5/8" surface casing, 15 sx of gel and 2 sx of hulls. Released plug and mixed and dumped 100 sx of cement + 6% gel.

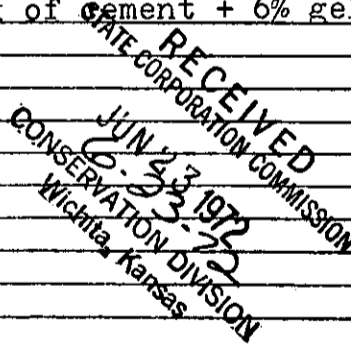

(If additional description is necessary, use BACK of this sheet)
Name of Plugging Contractor RUSS CASING PULLING, INC.
Address P. O. Box 1082 ; Great Bend, Kansas 67530

STATE OF Kansas, COUNTY OF Sedgwick, ss.
Dale M. Robinson (employee of owner) or (owner or operator) of the above-described well, being first duly sworn on oath, says: That I have knowledge of the facts, statements, and matters herein contained and the log of the above-described well as filed and that the same are true and correct. So help me God.

(Signature) Dale M. Robinson
705 Fourth National Bank Bldg. Wichita, Kansas
(Address)



Subscribed and sworn to before me this 22nd day of June, 1972
Esther Lamone
Notary Public.

ROTARY DRILLING LOG

15-135-30187-0000

COMPANY: **PICKRELL DRILLING COMPANY**
705 Fourth National Bank Bldg.
Wichita, Kansas

Rotary Drilling Commenced April 2, 1966

Rotary Drilling Completed April 10, 1966

LOCATION: **Gross "A" No. 1, 150' W of C SE NW Section 18-20S-22W, Ness County, Kansas.**

CONTRACTOR: **PICKRELL DRILLING COMPANY**
Wichita, Kansas

CASING RECORD: **247' (11 jts) 8 5/8" surface casing set with 155 sacks cement. Circulated. (141 jts) 5 1/2" casing set at 4334' with 150 sacks cement. Completed 6:15 P.M. April 10, 1966.**

RECEIVED
STATE CORPORATION COMMISSION
MAP 28 1972
CONSERVATION DIVISION
Wichita, Kansas

LOG

(Figures indicate bottom of formation — measurements from top of rotary bushing.)

40	Post Rock	<u>C. F. S.</u>
100	Post Rock & Shale	4254
180	Shale & Sand	4330
220	Sand	4344
605	Shale & Shells	
840	Red Beds	<u>Slope Tests</u>
850	Blaine	1500
895	Shale, Shells & Red Beds	2500
1100	Sand	3500
2160	Shale & Shells	4000
2400	Shale & Lime	
2600	Lime	
3880	Lime & Shale	<u>S. L. M.</u>
3990	Lime	2372
4344	Lime & Shale - RTD	3233
		4165

The undersigned, C. W. SEBITS, Attorney-in-Fact for PICKRELL DRILLING COMPANY, hereby certifies in behalf of said Company, that the above is a true and correct log of the formation encountered in drilling the above well as reflected by the Daily Drilling Reports.

PICKRELL DRILLING COMPANY

By C. W. SEBITS, Attorney-in-Fact

STATE OF KANSAS }
COUNTY OF SEDGWICK } ss.:

On this 13th day of April, 1966, before me the undersigned, a Notary Public, in and for the County and State aforesaid, personally appeared C. W. SEBITS, to me known to be the identical person who subscribed the name of PICKRELL DRILLING COMPANY to the foregoing instrument as its Attorney-in-Fact and acknowledged to me that he executed the same as his free and voluntary act and deed, and as the free and voluntary act and deed of such company, for the uses and purposes therein set forth.

Given under my hand and seal of office the day and year last above written.

My commission expires: June 21, 1966

Maxine Blackman
Notary Public
Maxine Blackman,