


WELL PLUGGING RECORD

Give All Information Completely
Make Required Affidavit
Mail or Deliver Report to:
Conservation Division
State Corporation Commission
212 North Market, Insurance Bldg.
Wichita, Kansas

Ness County, Sec. 13 Twp 20S Rge. 22W (E) (W)

Location as "NE/CNW&SW" or footage from lines C SE SW
Lease Owner Sinclair Oil & Gas Company
Lease Name Fred Janke Well No. 1
Office Address Route # 1 - Great Bend, Kansas 67530
Character of Well (completed as Oil, Gas or Dry Hole) Dry Hole
Date well completed February 8, 19 65
Application for plugging filed February 9, 19 65
Application for plugging approved February 10, 19 65
Plugging commenced February 8, 19 65
Plugging completed February 8, 19 65
Reason for abandonment of well or producing formation Non-Commercial oil well.

NORTH

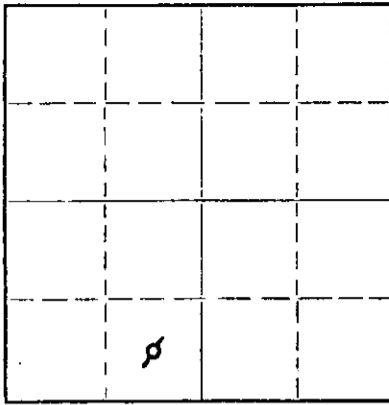

Locate well correctly on above
Section Plat

If a producing well is abandoned, date of last production - 19 -
Was permission obtained from the Conservation Division or its agents before plugging was commenced? Yes

Name of Conservation Agent who supervised plugging of this well Mr. Eldon Petty - Hays, Kansas
Producing formation Mississippi Depth to top 4375 Bottom 4390 Total Depth of Well 4431 Feet
Show depth and thickness of all water, oil and gas formations.

OIL, GAS OR WATER RECORDS

CASING RECORD

FORMATION	CONTENT	FROM	TO	SIZE	PUT IN	PULLED OUT
Mississippi Lime	9' Mud. 1' Muddy Water	4375'	4390'	8-5/8" OD	1451'	None Pulled.
Mississippi Lime	15' mud.	4376	4395			
Mississippi Lime	210' gas, 50' 540' clean oil 270' muddy water (salty)	4389	4399			

Describe in detail the manner in which the well was plugged, indicating where the mud fluid was placed and the method or methods used in introducing it into the hole. If cement or other plugs were used, state the character of same and depth placed, from _____ feet to _____ feet for each plug set.

Mudded from 4431 feet to 540 feet. Set wood plug. Spotted 20 sacks common cement from 540 feet to 480 feet (60'). Mudded from 480 feet to 240 feet. Set wood plug. Spotted 20 sacks cement from 240 feet to 180 feet (60'). Mudded from 180 feet to 40 feet. Set wood plug and hulls. Capped with 10 sacks cement. Job completed @ 12:00 P.M. 2-8-65. PLUGGED AND ABANDONED AS PER INSTRUCTIONS OF MR. ELDON PETTY, STATE PLUGGING AGENT, HAYS, KANSAS.

RECEIVED
STATE CORPORATION COMMISSION
FEB 15 1965
2-15-65
CONSERVATION DIVISION
Wichita, Kansas

(If additional description is necessary, use BACK of this sheet)

Name of Plugging Contractor Rains & Williamson
Address 1425 Wichita Plaza Building - Wichita, Kansas 67202

STATE OF KANSAS, COUNTY OF BARTON, ss.
J. F. DONHAM (employee of owner) or (owner or operator) of the above-described well, being first duly sworn on oath, says: That I have knowledge of the facts, statements, and matters herein contained and the log of the above-described well as filed and that the same are true and correct. So help me God.

(Signature) J. F. Donham
ROUTE # 1 - GREAT BEND, KANSAS 67530
(Address)

SUBSCRIBED AND SWORN TO before me this 11 day of FEBRUARY, 19 65

My commission expires July 12, 1967 Fred E. Vobornik Notary Public.

15.135.30012.0000

ROTARY DRILLING LOG

Operator: Sinclair Oil & Gas Company Contractor: Rains & Williamson
 No. 1 Fred Janke Oil Co.
 C SE SW Section 13-20S-22W Commenced: 1-23-65
 Ness County, Kansas Completed: 2-8-65
 Remarks: Set 1456' 8-5/8" surface casing with 700 sacks posmix, 2% calcium chloride.

FORMATIONS:

Surface Clay & Post Rock	69'
Shale & Sand Streaks	635'
Red Bed	688'
Anhydrite	696'
Red Bed & Shale	885'
Sand	1091'
Shale	1446'
Anhydrite	1482'
Shale & Shells	1605'
Shale	2165'
Shale & Lime	2270'
Lime & Shale	2730'
Shale & Lime	3775'
Lime	4431'
Rotary Total Depth (D&A)	4431'

RECEIVED
 STATE CORPORATION COMMISSION
 FEB 17 1965
 CONSERVATION DIVISION
 Wichita, Kansas

We certify the above log is true and correct to the best of our knowledge and belief.

RAINS & WILLIAMSON OIL CO.

Wilson Rains
 Wilson Rains, Partner

Subscribed and sworn to before me a Notary Public in and for the State of Kansas, County of Sedgwick, this 10th day of February, 1965.

My Commission Expires:

January 8, 1968

Shirley Keck
 Shirley Keck, Notary Public