


15735-21142-0000

STATE OF KANSAS
STATE CORPORATION COMMISSION
CONSERVATION DIVISION
P. O. BOX 17027
WICHITA, KANSAS 67217

WELL PLUGGING RECORD

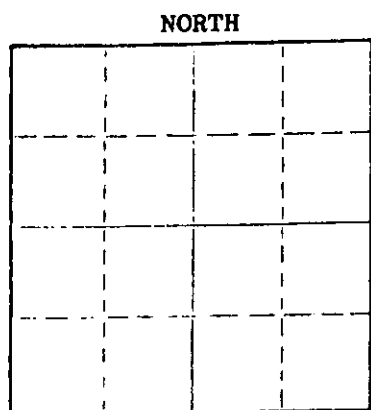

Location as "NE/CNV&SW¼" or footage from lines 300' FSL & 1980' FWL
County. Sec. 13 Twp. 20S Rge. 22W (E) (W)
Lease Owner RAINS & WILLIAMSON OIL CO., INC.
Lease Name JANKE Well No. 1
Office Address 435 PAGE COURT, 220W. DOUGLAS, WICHITA, KS. 67202
Character of Well (completed as Oil, Gas or Dry Hole) DRY HOLE
Date well completed 12-31-75 19
Application for plugging filed 12-31-75 19
Application for plugging approved 12-31-75 19
Plugging commenced 12-31-75 19
Plugging completed 12-31-75 19
Reason for abandonment of well or producing formation COMMERCIAL QUANTITIES OF OIL NOT FOUND.

If a producing well is abandoned, date of last production _____ 19
Was permission obtained from the Conservation Division or its agents before plugging was commenced? YES

Name of Conservation Agent who supervised plugging of this well LEO MASSEY - HAYS, KANSAS
Producing formation _____ Depth to top _____ Bottom _____ Total Depth of Well 4425'
Show depth and thickness of all water, oil and gas formations.

OIL, GAS OR WATER RECORDS				CASING RECORD		
FORMATION	CONTENT	FROM	TO	SIZE	PUT IN	PULLED OUT
				8 5/8"	289'	

Describe in detail the manner in which the well was plugged, indicating where the mud fluid was placed and the method or methods used in introducing it into the hole. If cement or other plugs were used, state the character of same and depth placed, from _____ feet to _____ feet for each plug set.

Plug @ 550' w/50 sxs.
240' w/25 sxs.
Bridge & plug @ 40' w/10 sxs.

RECEIVED
STATE CORPORATION COMMISSION
JAN 7 1976
7-76
CONSERVATION DIVISION
Wichita, Kansas

(If additional description is necessary, use BACK of this sheet)
Name of Plugging Contractor RAINS & WILLIAMSON OIL CO., INC.
Address 435 PAGE COURT, 220 WEST DOUGLAS, WICHITA, KS. 67202

STATE OF KANSAS COUNTY OF SEDGWICK
WILSON RAINS, PRESIENT, RAINS & WILLIAMSON OIL CO., INC.
(employee of owner) or (owner or operator) of the above-described

well, being first duly sworn on oath, says: That I have knowledge of the facts, statements, and matters herein contained and the log of the above-described well as filed and that the same are true and correct. So help me God.

(Signature) Wilson Rains WILSON RAINS
435 PAGE COURT, 220 W. DOUGLAS, WICHITA, KS 67202
(Address)

RECORDED AND SWORN to before me this 6th day of JANUARY 1976



OCTOBER 4, 1979

Juanita M. Green
JUANITA M. GREEN Notary Public.

WELL LOG

15735-21172-0000


COMPANY RAINS & WILLIAMSON OIL CO., INC.

SEC. 13 T. 20S R. 22W
LOC. 300" FSL & 1980 FWL

FARM JANKE NO. 1

RIG. NO. 1

COUNTY NESS
KANSAS

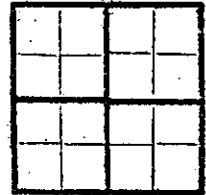

TOTAL DEPTH 4425'

COMM. 12-19-75

COMP. 12-31-75

CONTRACTOR RAINS & WILLIAMSON OIL CO., INC.

CASING

20 10
15 8-5/8" @ 289' w/175' sxs common.
12 6 2% gel. 3% cc.
13 5

ELEVATION 2245 KB

PRODUCTION D & A

FIGURES INDICATE BOTTOM OF FORMATIONS

CLAY, SHALE & SAND	1435
ANHYDRITE	1483
SHALE	1659
SHALE & LIME	2543
LIME	2748
LIME & SHALE	2988
LIME WITH SHALE	3196
LIME & SHALE	3690
LIME WITH SHALE	3868
LIME	3949
LIME WITH SHALE	4042
LIME	4295
SHALE & LIME	4389
LIME	4425
<u>ROTARY TOTAL DEPTH</u>	<u>4425</u>

RECEIVED
STATE CORPORATION COMMISSION

JAN 7 1976

CONSERVATION DIVISION
Wichita, Kansas

State of KANSAS
County of SEDGWICK ss:

I, WILSON RAINS, PRESIDENT of the RAINS & WILLIAMSON OIL CO., INC. Company

upon oath state that the above and foregoing is a true and correct copy of the log of the JANKE #1 well.

Wilson Rains
WILSON RAINS

WILSON RAINS

19 76

Subscribed and sworn to before me this 6th day of JANUARY

My Commission Expires: OCTOBER 4, 1979

Juanita M. Green
NOTARY PUBLIC
JUANITA M. GREEN

