


All Information Completely
Required Affidavit
or Deliver Report to:
Conservation Division
State Corporation Commission
211 No. Broadway
Wichita, Kansas

WELL PLUGGING RECORD

NORTH

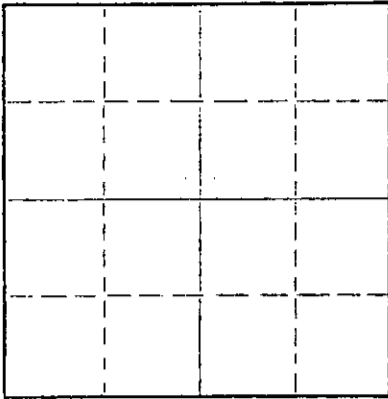

Locate well correctly on above
Section Plat

Barber County, Sec. 7 Twp. 30 Rge. 14 (E2) (W)
Location as "NE/CNW/SE/SW" or footage from lines C NE NW
Lease Owner Leben Drilling, Inc.
Lease Name ~~XXXXXXXXXXXX~~ Weede Well No. 1
Office Address P. O. Box 486, Great Bend, Kansas
Character of Well (completed as Oil, Gas or Dry Hole) Dry Hole
Date well completed 5-20-64 19__
Application for plugging filed 5-20-64 19__
Application for plugging approved 5-20-64 19__
Plugging commenced 5-20-64 19__
Plugging completed 5-20-64 19__
Reason for abandonment of well or producing formation Dry Hole

If a producing well is abandoned, date of last production 19__
Was permission obtained from the Conservation Division or its agents before plugging was commenced? yes

Name of Conservation Agent who supervised plugging of this well Archie Elving, Pratt, Kansas
Producing formation _____ Depth to top _____ Bottom _____ Total Depth of Well 4635 Feet
Show depth and thickness of all water, oil and gas formations.

OIL, GAS OR WATER RECORDS

CASING RECORD

FORMATION	CONTENT	FROM	TO	SIZE	PUT IN	PULLED OUT
				8 5/8"	320'	none

Describe in detail the manner in which the well was plugged, indicating where the mud fluid was placed and the method or methods used in introducing it into the hole. If cement or other plugs were used, state the character of same and depth placed, from _____ feet to _____ feet for each plug set.

RECEIVED
STATE CORPORATION COMMISSION

MAY 28 1964
5-28-64
CONSERVATION DIVISION
Wichita, Kansas

Filled with mud to 275' Plug 1/2 sack hulls 25 sacks cement
Filled with mud to 40' Plug 1/2 sack hulls 10 sacks cement
2 sacks in rathole.

(If additional description is necessary, use BACK of this sheet)

Name of Plugging Contractor Leben Drilling, Inc.
Address P. O. Box 486, Great Bend, Kansas

STATE OF KANSAS, COUNTY OF BARTON, ss.
Leslie Kite

(employee of owner) or (owner or operator) of the above-described well, being first duly sworn on oath, says: That I have knowledge of the facts, statements, and matters herein contained and the log of the above-described well as filed and that the same are true and correct. So help me God.

(Signature) Leslie Kite
P.O. Box 486, Great Bend, Kansas
(Address)

SUBSCRIBED AND SWORN TO before me this 25th day of May, 19 64

My commission expires April 1, 1967

Ulanda Nichols
Ulanda Nichols Notary Public.

DRILLER'S LOG

COMPANY: Leben Drilling, Inc.
 CONTRACTOR: LEBEN DRILLING, INC.
 FARM: WEEDE #1
 LOCATION: C NE NW Sec. 7-30-14
 BARBER COUNTY, KANSAS
 COMMENCED: 5-8-64
 COMPLETED: 5-20-64

0	45	Sand
45	90	Clay & Sand
90	300	Redbed
300	600	Redbed & Shale
600	1007	Shale & Shells
1007	1150	Shale
1150	1910	Shale & Shells
1910	2565	Lime & Shale
2565	3580	Shale & Lime
3580	3763	Lime & Shale
3763	3884	Lime
3884	4063	Lime & Shale
4063	4490	Lime
4490	4590	Lime & Chert
4590	4595	Lime
4595	4635	Core #1
	<u>4635</u>	<u>Rotary Total Depth - D. & A.</u>

RECEIVED
 STATE CORPORATION COMMISSION
 MAY 28 1964
 5-28-64
 CONSERVATION DIVISION
 Wichita, Kansas

Set 8 5/8" used surface casing @ 320' with landing joint cemented with 300 sacks Sunset with 2% Gel.

I, Leslie Kite, do hereby certify that the above and foregoing is a true and correct copy of the Weede #1 well, located C NE NW of Section 7, Township 30, Range 14, Barber County, Kansas, as reflected by the files of Leben Drilling, Inc.

Leslie Kite
 Leslie Kite

STATE OF KANSAS)
) SS
 COUNTY OF BARTON)

Subscribed and sworn to before me, a Notary Public, in and for Barton County, Kansas, this 25th day of May, 1964.

Ulanda Nichols
 Ulanda Nichols

My Commission Expires
 April 1, 1967