


STATE OF KANSAS
STATE CORPORATION COMMISSION

WELL PLUGGING RECORD

Give All Information Completely
Make Required Affidavit
Mail or Deliver Report to:
Conservation Division
State Corporation Commission
211 No. Broadway
Wichita, Kansas

NORTH

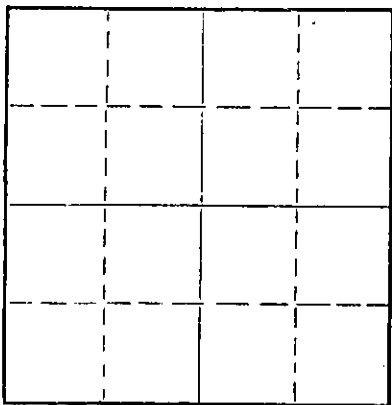

Locate well correctly on above
Section Plat

Ness County. Sec. 14 Twp 20S Rge. (E) 22 (W)

Location as "NE/CNWxSWx" or footage from lines C SE SE

Lease Owner Colorado Oil and Gas Corporation

Lease Name STOECKLEIN Well No. 1

Office Address Box 1030, Wichita, Kansas

Character of Well (completed as Oil, Gas or Dry Hole) Dry Hole

Date well completed August 9 19 64

Application for plugging filed August 9 19 64

Application for plugging approved August 9 19 64

Plugging commenced August 9 19 64

Plugging completed August 9 19 64

Reason for abandonment of well or producing formation No oil or gas found
in commercial quantities.

If a producing well is abandoned, date of last production - - 19

Was permission obtained from the Conservation Division or its agents before plugging was commenced? Yes

Name of Conservation Agent who supervised plugging of this well Eldon Petty, Hays, Kansas

Producing formation Depth to top Bottom Total Depth of Well 4474 Feet

Show depth and thickness of all water, oil and gas formations.

OIL, GAS OR WATER RECORDS

CASING RECORD

FORMATION	CONTENT	FROM	TO	SIZE	PUT IN	PULLED OUT
				8-5/8"	539.21'	None

Describe in detail the manner in which the well was plugged, indicating where the mud fluid was placed and the method or methods used in introducing it into the hole. If cement or other plugs were used, state the character of same and depth placed, from feet to feet for each plug set.

Set plug @ 530' with 20 sacks cement. Set plug @ 240' with 20 sacks cement. Mud back to 40'. Plug and hulls. Capped with 10 sacks cement. Plug down 2:30 p.m. 8-9-64.

RECEIVED
STATE CORPORATION COMMISSION

AUG 20 1964
8-20-64
CONSERVATION DIVISION
Wichita, Kansas

(If additional description is necessary, use BACK of this sheet)

Name of Plugging Contractor Rains & Williamson Oil Co.

Address 1425 Wichita Plaza, Wichita 2, Kansas

STATE OF KANSAS, COUNTY OF SEDGWICK, ss.
Wilson Rains

well, being first duly sworn on oath, says: That I have knowledge of the facts, statements, and matters herein contained and the log of the above-described well as filed and that the same are true and correct. So help me God.

(Signature) Wilson Rains
Wilson Rains
1425 Wichita Plaza, Wichita, Kansas
(Address)

SUBSCRIBED AND SWORN to before me this 11th day of August, 1964

My commission expires January 8, 1968

Shirley Keck
Notary Public

KS-735-19154-0000

ROTARY DRILLING LOG

Operator: Colorado Oil & Gas Corp.
No. 1 STOECKLEIN
C SE SE Sec. 14-20S-22W
Ness County, Kansas

Contractor: Rains & Williamson Oil Co.
Commenced: 7-28-64
Completed: 8-9-64
Remarks: Set 3-5/8" surface casing
with 250 sacks cement @ 541'.

Formations:

Post rock & Clay	50'
Shale & Sand	541'
Shale	620'
Red Bed	815'
Anhydrite	830'
Shale	905'
Sand	1130'
Red Bed & Sandy Shale	1467'
Anhydrite	1500'
Shale & Shells	1680'
Shale & Lime Streaks	1960'
Shale	2130'
Lime & Shale	2645'
Shale & Lime	2905'
Shale	3020'
Lime Chalky	3200'
Lime & Chalky Lime	3295'
Lime & Shale	3455'
Lime	4075'
Lime & Shale	4115'
Lime	4386'
Lime & Chert	4428'
Lime	4466'
Shale	4474'
Rotary Total Depth(D&A)	4474'

RECEIVED
STATE CORPORATION COMMISSION

AUG 18 1964

CONSERVATION DIVISION
Wichita, Kansas

We certify the above log is true
and correct to the best of our
knowledge and belief.

RAINS & WILLIAMSON OIL CO.

Wilson Rains
Wilson Rains, Partner

Subscribed and sworn to before me, a Notary Public in and for the State
of Kansas, County of Sedgwick, this 11th day of August, 1964.

My Commission Expires: 1-8-68

Shirley Keck
Shirley Keck, Notary Public