

B

KANSAS

STATE CORPORATION COMMISSION

CONSERVATION DIVISION AGENT'S REPORT

J. Lewis Brock  
Administrator  
245 North Water  
Wichita, KS 67202

API Number 15-007-10009-00-01 (of this well)

Operator's Full Name Texas Oil & Gas Corporation

Complete Address 200 W. Douglas, Suite 300, Wichita, Ks. 67202

Lease Name Stewart "B" Well No. 1

Location NE SE SE Sec. 15 Twp. 32 Rge. 11 (E) (W) X

County Barber Total Depth 3008

Abandoned Oil Well        Gas Well X Input Well        SWD Well        D & A       

Other well as hereafter indicated       

Plugging Contractor Clarke Corporation

Address 107 W. Fowler, Medicine Lodge, Ks. 67104 License No. 583

Operation Completed: Hour 9:30 Am. Day 3 Month 7 Year 1979

The above well was plugged as follows:

191' 8 5/8" casing w/125 sax cement. 4 1/2" casing set at 2715'-Pref-  
-orated at 2565'-Cement retainer at 2582'-Sand back to 2500'-Top sand  
w/4 sax mixed cement w/ dump bailer. Pull 2292' 4 1/2" casing-Build  
bridge at 185'-Dump 3/4 yard ready mix cement below bridge & 3 1/4  
yard ready mix cement on top of bridge to top of casing.

Harper Ready Mix. Harper, Kansas.

RECEIVED  
STATE CORPORATION COMMISSION  
7-5-79  
JUL - 5 1979

I hereby certify that the above well was plugged as herein stated at Wichita, Kansas

Conservation Division  
Signed: [Signature]  
Well Plugging Supervisor

INVOICED

DATE 7-5-79


INV. NO. 9964-W

15-007-10009-00-01

WELL : STEWART 'B' #1 (LOWWO)

LOCATION : 990' FSL + 330' FEL SEC. 15-32S-11W BARBER Co., KS.

ELEVATION : 1508' G.L. 1516' K.B.

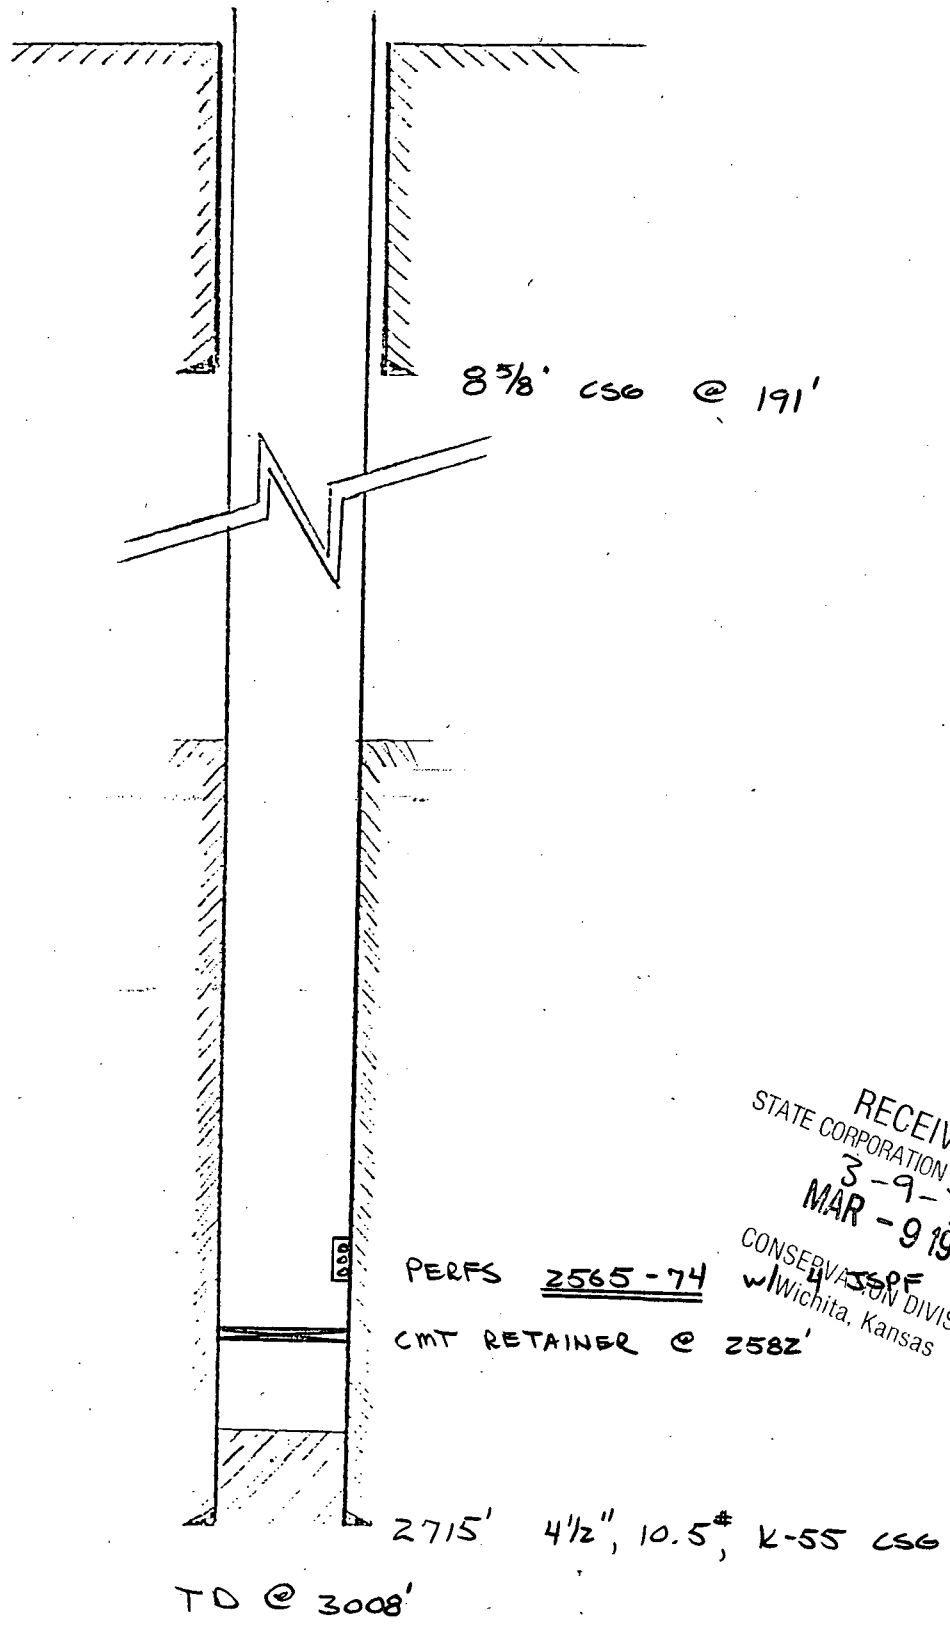

RECEIVED  
 STATE CORPORATION COMMISSION  
 3-9-79  
 MAR - 9 1979  
 CONSERVATION DIVISION  
 w/ Wichita, Kansas