

15-007-3029-0000


Give All Information Completely
Make Required Affidavit
Mail or Deliver Report to:
Conservation Division
State Corporation Commission
211 No. Broadway
Wichita, Kansas

WELL PLUGGING RECORD

Barber County, Sec. 1 Twp. 31 S Rge. (E) 14 (W)

Location as "NE/CNW%SW%" or footage from lines SW NE SE
Lease Owner Aylward Drilling Company
Lease Name Skinner "F" Well No. 1
Office Address 909 First National Bank Bldg., Wichita, Kansas
Character of Well (completed as Oil, Gas or Dry Hole) Oil
Date well completed September 15, 1964
Application for plugging filed July 8, 1965
Application for plugging approved July 8, 1965
Plugging commenced July 16, 1965
Plugging completed July 21, 1965
Reason for abandonment of well or producing formation Depleted

NORTH

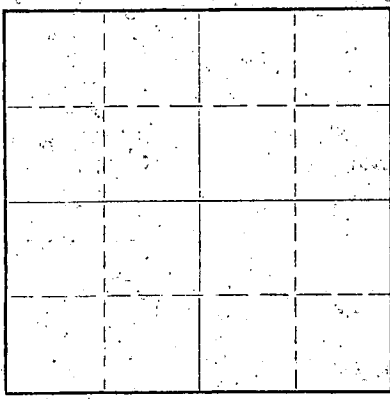

Locate well correctly on above Section Plat

If a producing well is abandoned, date of last production July 1, 1965
Was permission obtained from the Conservation Division or its agents before plugging was commenced? Yes

Name of Conservation Agent who supervised plugging of this well Archie Elving
Producing formation Viola Depth to top Bottom Total Depth of Well 4405 Feet
Show depth and thickness of all water, oil and gas formations.

OIL, GAS OR WATER RECORDS

CASING RECORD

FORMATION	CONTENT	FROM	TO	SIZE	PUT IN	PULLED OUT
				8 5/8"	124'	None
				5 1/2"	4404'	3626.50'

Describe in detail the manner in which the well was plugged, indicating where the mud fluid was placed and the method or methods used in introducing it into the hole. If cement or other plugs were used, state the character of same and depth placed, from feet to feet for each plug set.

Filled bottom from 4405' to 4400' and dump 5 sacks cement.
Set 10' rock bridge from 180' to 170'. Mud hole to 150';
set 10' rock bridge and dumped 30 sacks cement. Mud hole
to 40', set 10' rock bridge and dumped 10 sacks cement to
surface.

RECEIVED
STATE CORPORATION COMMISSION

AUG 23 1965
8-23-65
CONSERVATION DIVISION
Wichita, Kansas

(If additional description is necessary, use BACK of this sheet)

Name of Plugging Contractor Flint Engineering & Construction Co.
Address P. O. Box 950, El Dorado, Kansas ; 67042

STATE OF KANSAS, COUNTY OF SEDGWICK, ss.
R. A. Aylward (employee of owner) or (owner or operator) of the above-described well, being first duly sworn on oath, says: That I have knowledge of the facts, statements, and matters herein contained and the log of the above-described well as filed and that the same are true and correct. So help me God.

(Signature) R. A. Aylward
909 1st Nat'l Bank Bldg., Wichita, Kansas
(Address)

SUBSCRIBED AND SWORN TO before me this 4th day of August, 1965

My commission expires May 14, 1968

Notary Public.



SKINNER "F" #1

Casing Record:

8 5/8" - 124'
5 1/2" - 4404'

Company: Aylward Drilling Company et al
Contractor: Aylward Drilling Company

Commenced: September 1, 1964
Completed: September 15, 1964

Location:
SW NE SE Sec. 1-31-14W
Barber County, Kansas
Elev. 1697 D.F.
1700 R.B.

	<u>From</u>	<u>To</u>	<u>Remarks</u>	
Red Rock	0	124	Set 8 5/8" surface pipe @ 124' w/200 sacks	
Red Rock & Shale	124	1035		
Shale & Shells	1035	1630	Geological Tops:	
Lime & Shale	1630	3330		
Lime	3330	3445		
Lime & Shale	3445	3665		Heebner 3640
Shale	3665	3760		Douglas Shale 3698
Lime & Shale	3760	3837		Douglas Sand 3772
Lime	3837	4160		Brown Lime 3817
Lime & Chert	4160	4186		Lansing 3828
Lime	4186	4300		Base/Kansas City 4236
Lime & Chert	4300	4306		Marmaton 4256
Lime	4306	4405 T.D.		Mississippian 4316
				Kinderhook Shale 4347
				Viola 4403
				R.T.D. 4405
			DST 4250-4306 Open 2 hrs. Rec. 30" Mud IBHP 226#/45" - FBHP 217#/45" FP 43#-71#	
			DST 4316-37 Open 2 hrs. Rec. 20" Mud IBHP 417#/45" - FBHP 662#/1 hr. FP 9#-18#	
			DST 4398-4405 Open 2 hrs. GTS/6" 139 MCFG/5" - dec. TSTM Rec. 65" HG&OCM-HM&GCO IBHP 1126#/45" - FBHP 1060#/45" FP 9#-28#	
			Set 5 1/2" casing @ 4404' w/50 sacks	

RECEIVED
STATE CORPORATION COMMISSION

AUG 23 1965
8-23-65
CONSERVATION DIVISION
Wichita, Kansas

I hereby certify that this is a true and correct copy of the above log to the best of my knowledge.

Duane Jessup

Subscribed and sworn to before me this 25th day of September, 1964

Joseph A. Hess
JOSEPH A. HESS Notary Public

My commission expires May 14, 1968