

15-007-00293-0000

WELL PLUGGING RECORD


STATE OF KANSAS STATE CORPORATION COMMISSION

Give All Information Completely Make Required Affidavit Mail or Deliver Report to: Conservation Division State Corporation Commission 800 Biting Building Wichita, Kansas

FORMATION PLUGGING RECORD

Strike out upper line when reporting plugging off formations.

Barber County. Sec. 1 Twp. 31 Rge. 14 (W) Location as "NE 1/4 NW 1/4 SW 1/4" or footage from lines W/2 SW/4 SW/4 Lease Owner: The Drillers Gas Company Lease Name: Pearl Lake Well No. 1 Office Address: 903 Union National Bldg., Wichita 2, Kansas Character of Well (completed as Oil, Gas or Dry Hole): Gas well Date well completed: October 7 1945 Application for plugging filed: September 21 1949 Application for plugging approved: " 22 1949 Plugging commenced: " 24 1949 Plugging completed: October 1 1949 Reason for abandonment of well or producing formation: Ceased producing gas

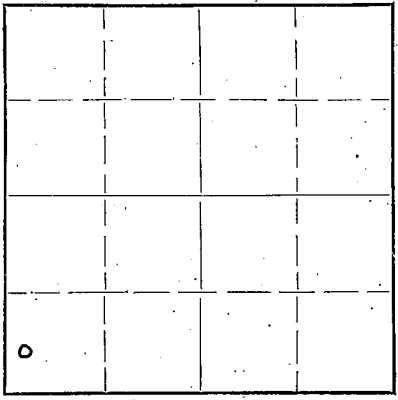

Locate well correctly on above Section Plat

If a producing well is abandoned, date of last production: May 1949 Was permission obtained from the Conservation Division or its agents before plugging was commenced? Yes

Name of Conservation Agent who supervised plugging of this well: C. D. Stough Producing formation: Maquoketa - Viola Depth to top: 4400 Bottom: ? Total Depth of Well: 4409 1/2 Feet Show depth and thickness of all water, oil and gas formations.

OIL, GAS OR WATER RECORDS

CASING RECORD

Table with 7 columns: Formation, Content, From, To, Size, Put In, Pulled Out. Row 1: Maquoketa - Viola, 4400, 4409 1/2, 10", 688', 0. Row 2: 7", 4401', 2704'

Describe in detail the manner in which the well was plugged, indicating where the mud fluid was placed and the method or methods used in introducing it into the hole. If cement or other plugs were used, state the character of same and depth placed, from feet to feet for each plug set.

Dumped 6 sacks cement at bottom of hole Shot off and pulled 2704' of pipe Filled hole with mud to 250' Dumped 15 sacks cement @ 250' Mudded from 250' to surface 5 sacks cement at top of surface pipe

RECEIVED Conservation Div. 10-7-49 OCT 7 X 1949 STATE CORPORATION COMMISSION KANSAS

Correspondence regarding this well should be addressed to: The Drillers Gas Company Address: 903 Union National Bldg., Wichita 2, Kansas

STATE OF KANSAS COUNTY OF SEDGWICK M. R. Schwartzkopf (employee of owner)

being first duly sworn on oath, says: That I have knowledge of the facts, statements, and matters herein contained and the log of the above-described well as filed and that the same are true and correct. So help me God.

(Signature): M. R. Schwartzkopf 903 Union National Bldg., Wichita 2, Kansas (Address)

SUBSCRIBED AND SWORN TO before me this 6th day of October 1949

Bertha L. Wilson Notary Public

My commission expires August 13, 1951

PLUGGING FILE SEC. 1 T. 31 R. 14 DOCK PAGE 116 LINE 6

The Drillers Gas Co.,
Pearl Lake Well # 1

Located C West 20 Acres SW/4
SW/4, Section 1, Township 31S,
Range 14W, Barber County Kansas.

Total Depth 4409 1/2 Ft.
Comm. 8/22/45
Comp. 10/7/45
Contractor R. C. Patton Co.,

CASING RECORD
10 3/4" 10" O. D. Casing Set at
688 Ft. Cemented with 500 Sacks.
7" O.D. Casing Set at 4401 Ft.
Cemented with 300 Sacks.

Red Bed & Shells	600
Red Bed	623
Anhydrite	642
Red Bed & Shale	1100
Salt & Shale	1265
Shale & Shells	1733
Lime	1763
Shale & Lime	1810
Lime	1850
Shale & Lime	1915
Lime 2105	2105
Shale & Lime	2183
Lime	2225
Shale & Lime	2453
Lime	2482
Shale & Lime	2533
Shale	2547
Shale & Shells	2715
Lime & Shale	2834
Shale & Shells	2922
Shale & Lime	2960
Lime	3084
Lime & Shale	3160
Lime	3290
Lime & Shale	3460
Lime	3540
Shale & Lime	3610
Lime	3617
Lime & Shale	3703
Sand	3725
Shale	3768
Shale & Lime	3788
Sand	3810
Shale	3827
Shale & Shells	3887
Lime	3898
Cherty lime	3910
Lime	3939
Shale & Lime	4016
Lime	4080
Cherty Lime	4099
Lime	4121
Lime Chat	4157
Lime Chert	4189
Lime Shale	4280
Lime	4315
Shale	4319
Lime & Shale	4341
Lime	4367
Shale	4401
Viola Lime	4409 1/2
Total Depth	4409 1/2

*IP 5 million cu ft gas
after 1000 and*

RECEIVED
9-22-49
SEP 22 1949
STATE CORPORATION
COMMISSION
KANSAS

STATE OF Kansas COUNTY OF Sedgwick ss

I, the undersigned, being duly sworn, on oath state that the above statement and log is a true and correct record and log of the well drilled at the location above described.

PLUGGING
FILE SEC 1 T 31 14W
BOOK PAGE 116 LINE 6

R. C. PATTON CO.,

By R. C. Patton

Subscribed and sworn to before me this 15th day of Oct 1945

My Commission Expires Oct 4th 1948

J. P. Hendrick
Notary Public