


15-007-01750-0000

STATE OF KANSAS  
STATE CORPORATION COMMISSION

WELL PLUGGING RECORD

Give All Information Completely  
Make Required Affidavit  
Mail or Deliver Report to:  
Conservation Division  
State Corporation Commission  
211 No. Broadway  
Wichita, Kansas

Barber County. Sec. 22 Twp. 32S Rge. 11 ~~(W)~~ (W)  
Location as "NE/CNW%SW%" or footage from lines NE NE NE  
Lease Owner Musgrove Petroleum Corp.  
Lease Name Gilbert Well No. 1  
Office Address 801 Union Center Building - Wichita, Kansas  
Character of Well (completed as Oil, Gas or Dry Hole) Dry Hole  
Date well completed 12-15 19 56  
Application for plugging filed 12-14 19 56  
Application for plugging approved 12-14 19 56  
Plugging commenced 12-14 19 56  
Plugging completed 12-15 19 56  
Reason for abandonment of well or producing formation No commercial shows of oil and/or gas.

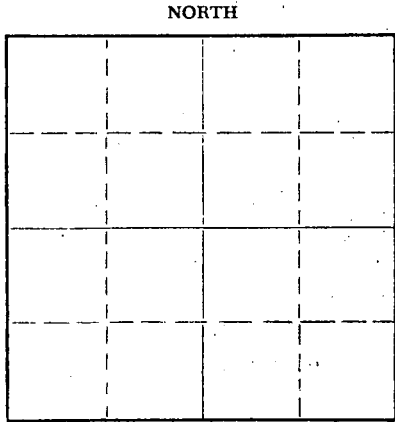

Locate well correctly on above Section Plat

If a producing well is abandoned, date of last production \_\_\_\_\_ 19\_\_\_\_  
Was permission obtained from the Conservation Division or its agents before plugging was commenced? Yes

Name of Conservation Agent who supervised plugging of this well Mr. Petty  
Producing formation \_\_\_\_\_ Depth to top \_\_\_\_\_ Bottom \_\_\_\_\_ Total Depth of Well 3660 Feet  
Show depth and thickness of all water, oil and gas formations.

OIL, GAS OR WATER RECORDS

CASING RECORD

FORMATION	CONTENT	FROM	TO	SIZE	PUT IN	PULLED OUT
Sand	Water	30	85	8 5/8	200	

Describe in detail the manner in which the well was plugged, indicating where the mud fluid was placed and the method or methods used in introducing it into the hole. If cement or other plugs were used, state the character of same and depth placed, from \_\_\_\_\_ feet to \_\_\_\_\_ feet for each plug set.

The hole was filled with drilling mud to 185', a Halliburton plug was set @ 185', topped with 1/2 sack hulls, and bridged with 20 sacks cement through drill pipe. Hole was then filled with mud to 40', Halliburton plug set @ 40', topped with 1/2 sack hulls, and filled to surface with cement.

RECEIVED  
STATE CORPORATION COMMISSION  
DEC 12 1956  
12-19-56  
CONSERVATION DIVISION  
Wichita, Kansas

(If additional description is necessary, use BACK of this sheet)

Name of Plugging Contractor Wilkinson Drilling, Inc.  
Address 1111 Union National Building - Wichita, Kansas

STATE OF Kansas, COUNTY OF Sedgwick, ss.  
Walter M. Wilkinson (employee of owner) or (owner or operator) of the above-described well, being first duly sworn on oath, says: That I have knowledge of the facts, statements, and matters herein contained and the log of the above-described well as filed and that the same are true and correct. So help me God.

(Signature) Walter M. Wilkinson  
1111 Union National Building - Wichita, Kans.  
(Address)

SUBSCRIBED AND SWORN TO before me this 18th day of December, 19 56

My commission expires July 28, 1958

Charlene Barlow  
Notary Public.

PLUGGING  
FILE SEC 22T 32 R 11W  
BOOK PAGE 126 LINE 17

GILBERT #1

Company - Musgrove Petroleum  
 Contractor - Wilkinson Drilling, Inc.  
 Commenced - 12/3/56  
 Completed - 12/15/56  
 Initial Prod. - D & A  
 Total Depth - 3660'

Location: NE-NE-NE, Section 22-32S-11W,  
 Barber County, Kansas  
 Elevation: 1510 KB  
 Casing: 190' - 8 5/8"

FIGURES INDICATE BOTTOMS OF FORMATIONS:

Depth	Formation
0 - 35	Surface
35 - 85	Sand
85 - 850	Red Bed w/Shale
850 - 1225	Shale & Shell (Rock)
1225 - 1240	Anhydrite
1240 - 1600	Anhydrite & Shale
1600 - 1675	Shale & Lime
1675 - 1965	Lime & Shale
1965 - 2165	Shale & Lime
2165 - 2550	Lime & Shale
2550 - 2740	Shale & Shells
2740 - 3010	Lime & Shale
3010 - 3095	Sandy Lime & Shale
3095 - 3320	Lime & Shale
3320 - 3560	Shale & Lime
3560 - 3587	Lime & Shale
3587 - 3601	Sand
3601 - 3660	Lime
3660 - T. D.	

We hereby certify the above and foregoing to be a true and correct copy of the Log on the Gilbert #1, located in the NE-NE-NE, of Section 22-32S-11W, Barber County, Kansas.

WILKINSON DRILLING, INCORPORATED

*Walter M. Wilkinson*

Subscribed and sworn to before me this 18th day of December, 1956.

*Charles B. Baskin*  
 Notary Public

My commission expires *July 28, 1958*

RECEIVED  
 STATE COMMISSION  
 12-19-56

STATE COMMISSION  
 Kansas

PLUGGING  
 FILE SEC 22 T 32 R 11W  
 BOOK PAGE 126 LINE 17