




WELL PLUGGING RECORD

Barber County, Sec. 22 Twp. 32S Rge. ~~11~~ 11 (W)
 Location as "NE/CNW/SW" or footage from lines. 150' NW of C of NE NW
 Lease Owner Sohio Petroleum Company
 Lease Name Donovan Well No. 1
 Office Address Box 673, Russell, Kansas 67665
 Character of Well (completed as Oil, Gas or Dry Hole) dry
 Date well completed 12-14 1968
 Application for plugging filed 19
 Application for plugging approved 19
 Plugging commenced 12-14 1968
 Plugging completed 12-14 1968
 Reason for abandonment of well or producing formation _____

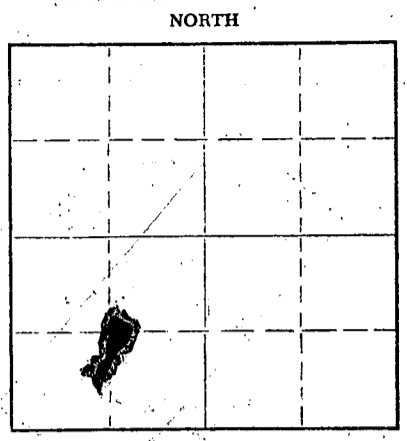

Locate well correctly on above Section Plat

If a producing well is abandoned, date of last production 19
 Was permission obtained from the Conservation Division or its agents before plugging was commenced? yes

Name of Conservation Agent who supervised plugging of this well Ralph Warren
 Producing formation _____ Depth to top _____ Bottom _____ Total Depth of Well 4,852 Feet
 Show depth and thickness of all water, oil and gas formations.

OIL, GAS OR WATER RECORDS CASING RECORD

FORMATION	CONTENT	FROM	TO	SIZE	PUT IN	PULLED OUT
				8-5/8	901'	none

Describe in detail the manner in which the well was plugged, indicating where the mud fluid was placed and the method or methods used in introducing it into the hole. If cement or other plugs were used, state the character of same and depth placed, from _____ feet to _____ feet for each plug set.

Filled hole with 300' of hvy mud. Pushed plug to 300' and 1/2 sack hulls on top of plug. Dumped 25 sacks dry cement in hole. Filled hole to 40' with hvy mud. Pushed 1/2 sack hulls to 40'. Pumped 10 sacks of cement on bridge, top of cement plug 3' below ground level.

RECEIVED
 STATE CORPORATION COMMISSION
 12-17-68
 DEC 17 1968
 CONSERVATION DIVISION
 Wichita, Kansas

(If additional description is necessary, use BACK of this sheet)
 Name of Plugging Contractor Gabbert-Jones, Inc.
 Address Wichita, Kansas

STATE OF KANSAS, COUNTY OF RUSSELL, ss.
D. W. Smith (employee of owner) or (owner or operator) of the above-described well, being first duly sworn on oath, says: That I have knowledge of the facts, statements, and matters herein contained and the log of the above-described well as filed and that the same are true and correct. So help me God.

(Signature) D. W. Smith
Box 673, Russell, Kansas 67665
 (Address)

SUBSCRIBED AND SWORN TO before me this 16th day of December, 19 68



9-28-71
Juanita Valentine Notary Public.

GABBERT-JONES, INC.
WICHITA, KANSAS
DRILLERS' WELL LOG

DONOVAN #1
C. NE NW Section 22-32S-11W
Barber County, Kansas

Commenced: November 23, 1968
Completed: December 13, 1968

OPERATOR - Sohio Petroleum Company

DEPTH		FORMATION	REMARKS
From	To		
0	390	Shale and red bed	
390	490	Red bed	
490	530	Shale and red bed	
530	913	Red bed	Ran 23 joints 8-5/8" casing, set @ 913' w/350 sacks cement.
913	1190	Shale	
1190	1405	Shale and shells	
1405	1555	Shale	
1555	3475	Lime and shale	
3475	3650	Shale, lime and sand	
3650	3760	Lime and shale	
3760	4597	Lime	
4597	4661	Shale and lime	
4661	4708	Lime	
4708	4803	Sand	
4803	4837	Shale	
4837	4852	Lime	
4852	TD		Dry and abandoned.

RECEIVED
STATE CORPORATION COMMISSION
12-23-68
DEC 23 1968
CONSERVATION DIVISION
Wichita, Kansas

I, E. E. HALL, certify this is a correct copy of the Drillers' Log for the well drilled in the C. NE NW Section 22-32S-11W, Barber County, Kansas, to the best of my knowledge and belief.

E. E. Hall
E. E. HALL

STATE OF KANSAS)
) SS
COUNTY OF SEDGWICK)

Before me, the undersigned, a Notary Public within and for said County and State, on this 17 day of December, 1968, personally appeared E. E. Hall to me personally known to be the identical person who executed the within and foregoing instrument and acknowledged to me that he executed the same as his free and voluntary act and deed for the uses and purposes therein set forth.

IN WITNESS WHEREOF, I have hereunto set my hand and official seal the day and year last above written.

Barbara J. Layton
Barbara J. Layton, Notary Public

My Commission Expires February 1, 1972.

