


STATE OF KANSAS
STATE CORPORATION COMMISSION

WELL PLUGGING RECORD

Give All Information Completely
Make Required Affidavit
Mail or Deliver Report to
Conservation Division
State Corporation Comm.
245 North Water
Wichita, KS 67202

BARBER County. Sec. 15 Twp. 32 Rge. 11 E/W
Location as "NE/CNW 1/4 SW 1/4" or footage from lines _____
990 FSL. 330 FEE.
Lease Owner Texas Oil and Gas Corporation
Lease Name Stewart Well No. 1 "B"
Office Address 200 W Douglas, Wichita 67202
Character of Well (Completed as Oil, Gas or Dry Hole) _____
GAS

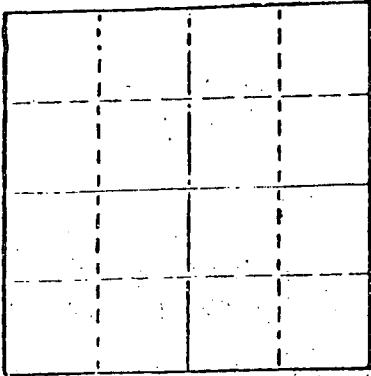

Locate well correctly on above
Section Plot

Date Well completed 12-3 19 78
Application for plugging filed 3-6 19 79
Application for plugging approved 3-6 19 79
Plugging commenced 6-27 19 79
Plugging completed 7-3 19 79
Reason for abandonment of well or producing formation _____

If a producing well is abandoned, date of last production _____ 19 _____

Was permission obtained from the Conservation Division or its agents before plugging was commenced? Yes

Name of Conservation Agent who supervised plugging of this well Bill Owens
Producing formation _____ Depth to top _____ Bottom _____ Total Depth of Well 3008
Show depth and thickness of all water, oil and gas formations.

OIL, GAS OR WATER RECORDS

CASING RECORD

FORMATION	CONTENT	FROM	TO	SIZE	PUT IN	PULLED OUT
				8 5/8	191	None
				4 1/2	2715	2292

Describe in detail the manner in which the well was plugged, indicating where the mud fluid was placed and the method or methods used in introducing it into the hold. If cement or other plugs were used, state the character of same and depth placed, from _____ feet to _____ feet for each plug set.

SAND FROM 2715 to 2500. 4 SACKS CEMENT 2500 to 2460. Bailer still in bottom of hole. Pulled 4 1/2". Wood bridge at 200. 4 Yards ready mix.

RECEIVED
STATE CORPORATION COMMISSION

NOV 08 1979

11-8-79

CONSERVATION DIVISION
Wichita, Kansas

(If additional description is necessary, use BACK of this sheet)

Name of Plugging Contractor CLARKE CORPORATION

STATE OF Kansas COUNTY OF Barber, ss.
Elmo R. Morgenstern (employee of owner) or (owner or operator)
of the above-described well, being first duly sworn on oath, says: That I have knowledge of the facts, statements, and matters herein contained and the log of the above-described well as filed and that the same are true and correct. So help me God.

(Signature) Elmo R. Morgenstern
Medicine Lodge, Co. 67104
(Address)

SUBSCRIBED AND SWORN TO before me this 6th day of July, 19 79

Jessie Hamilton
Notary Public.

My commission expires April 4, 1982