

STATE OF KANSAS
STATE CORPORATION COMMISSION


Give All Information Completely
Make Required Affidavit
Mail or Deliver Report to:
Conservation Division
State Corporation Commission
211 No. Broadway
Wichita, Kansas

WELL PLUGGING RECORD

Barber County, Sec. 15 Twp. 32S Rge. 11 ~~XX~~ W (W)

Location as "NE/CNW&SW" or footage from lines. NE SE SE
Lease Owner H. C. Bennett
Lease Name Stewart "D" Well No. 1
Office Address 1212 Union Nat'l Bldg., Wichita, Kansas
Character of Well (completed as Oil, Gas or Dry: Hole) S W D
Date well completed 12-09 19 56
Application for plugging filed 1-02 19 64
Application for plugging approved 1-04 19 64
Plugging commenced 1-15 19 64
Plugging completed 1-20 19 64
Reason for abandonment of well or producing formation abandon lease

NORTH

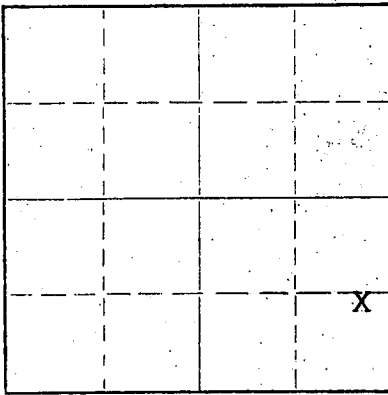

Locate well correctly on above
Section Plat

If a producing well is abandoned, date of last production _____ 19____
Was permission obtained from the Conservation Division or its agents before plugging was commenced? yes

Name of Conservation Agent who supervised plugging of this well Archie Elving
Producing formation _____ Depth to top _____ Bottom _____ Total Depth of Well 3597 Feet
Show depth and thickness of all water, oil and gas formations.

OIL, GAS OR WATER RECORDS

CASING RECORD

FORMATION	CONTENT	FROM	TO	SIZE	PUT IN	PULLED OUT
				8 5/8	191	circulated
				5 1/2	3614	3020

Describe in detail the manner in which the well was plugged, indicating where the mud fluid was placed and the method or methods used in introducing it into the hole. If cement or other plugs were used, state the character of same and depth placed, from _____ feet to _____ feet for each plug set.

Filled with chat from 3597 feet to 3580 feet and dumped 5 sacks cement. Pumped 15 sacks of jell and 80 sacks cement down 8 5/8 pipe, Top plug pumped by Halliburton.

RECEIVED
STATE CORPORATION COMMISSION

JAN 29 1964

1-29-64

CONSERVATION DIVISION
Wichita, Kansas

(If additional description is necessary, use BACK of this sheet)

Name of Plugging Contractor Flint Engineering & Construction Co.
Address Box 342, El Dorado, Kansas

STATE OF Kansas, COUNTY OF Butler, ss. _____
(employee of owner) or (owner or operator) of the above-described well, being first duly sworn on oath, says: That I have knowledge of the facts, statements, and matters herein contained and the log of the above-described well as filed and that the same are true and correct. So help me God.

(Signature) Mary Payne
El Dorado, Kansas
(Address)

SUBSCRIBED AND SWORN TO before me this 28th day of January, 19 64

My commission expires September 27, 1967

Ronald R. Hansen
Notary Public.



BEARDMORE-BARBARA
 #1 Stewart "D"
 NE SE SE Sec. 15-32S-11W
 Barber County, Kansas

Drilled By: Beardmore Drilling Company
 Drilling Commenced: 12-3-56
 Drilling Completed: 12-9-56

Casing Record:

Ran 193' of 8-5/8" set at 191' with 125 sacks. Cement circulated.
 12-2-56.
 3614' of 5-1/2" set at 3589' with 75 sacks. 12-9-56.

Elevations: KB 1514
 DF 1511
 Gr 1508

<u>FORMATIONS</u>	<u>DEPTH</u>
Cellar	5
Sand	100
Shale and Shells	191
Lime	1505
Shale and Lime	1600
Shale and Lime	2650
Shale	2925
Shale and Lime	3140
Shale and Lime	3576
Rotary Total Depth	3597

TOPS

Heebner	3564
Sand	3579

RECEIVED
 STATE CORPORATION COMMISSION

JAN 29 1964
 1-29-64
 CONSERVATION DIVISION
 Wichita, Kansas

CORE #1 3576-3587 Recovered 11'

CORE #2 3587-3597 Recovered 10'

DST #1 3580-3587 Open 1 hr., recovered 37' mud. FBHP 1038 in 15 min., IF 15, FF 30, temperature 95, fair blow throughout test.

DST #2 3585-3597 Open 1 hr., good blow, gas in 1 hr., recovered 20' oil specked mud, 60' oil cut mud, 60' muddy oil, 60' muddy oil, some free oil, no trace of water. FBHP 1300, IF 48, FF 95, temperature 95.

STATE OF KANSAS }
 COUNTY OF SEDGWICK } ss

I, the undersigned, being duly sworn on oath state that the above and within statement is a true and correct record and log of the well drilled on the location above described, to the best of my knowledge and belief.

Robert J. Tolle

Subscribed and sworn to before me this 18th day of December, 1956.

Leonard P. Tolle
 Leonard P. Tolle-Notary Public

My Commission Expires:
 January 28, 1960