


WELL PLUGGING RECORD

Give All Information Completely
Make Required Affidavit
Mail or Deliver Report to:
Conservation Division
State Corporation Commission
811 No. Broadway
Wichita, Kansas

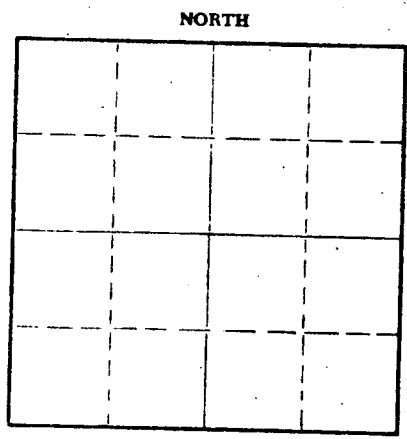

Locate well correctly on above Section Plat

Barber County, Sec. 15 Twp. 32 Rge. 11 (E) W (W)
Location as "NE/CNW/SW" or footage from lines SW NE SE
Lease Owner Beardmore Drilling Co.
Lease Name Stewart "D" #2 Well No. _____
Office Address Wichita, Kansas
Character of Well (completed as Oil, Gas or Dry Hole) _____
Date well completed _____
Application for plugging filed _____ 19____
Application for plugging approved _____ 19____
Plugging commenced 12-22-59 _____ 19____
Plugging completed 12-29-59 _____ 19____
Reason for abandonment of well or producing formation _____

If a producing well is abandoned, date of last production _____ 19____
Was permission obtained from the Conservation Division or its agents before plugging was commenced? yes

Name of Conservation Agent who supervised plugging of this well Fred Hampel
Producing formation _____ Depth to top _____ Bottom _____ Total Depth of Well 3602 Feet
Show depth and thickness of all water, oil and gas formations.

OIL, GAS OR WATER RECORDS

CASING RECORD

FORMATION	CONTENT	FROM	TO	SIZE	PUT IN	PULLED OUT
				8-5/8"	216'	none
				5-1/2"	3597'	2606'

Describe in detail the manner in which the well was plugged, indicating where the mud fluid was placed and the method or methods used in introducing it into the hole. If cement or other plugs were used, state the character of same and depth placed, from _____ feet to _____ feet for each plug set.

Checked the hole to 3611' and found it open.
Filled w/sand to 3587' and dumped 5 sacks of cement with bailer. Pulled 5 1/2" casing.
Cleared hole and bailed hole to 210', set rock bridge to 200' and dumped 25 sacks of cement.
Mudded the hole to 40', set rock bridge to 30' and ran 10 sacks of cement to base of cellar.

PLUGGING COMPLETED

RECEIVED
STATE CORPORATION COMMISSION
MAY 1 1963
5-1-63
CONSERVATION DIVISION
Wichita, Kansas

Name of Plugging Contractor Knight Casing Pulling Co. (If additional description is necessary, use BACK of this sheet)
Address Chase, Kansas

STATE OF KANSAS COUNTY OF RICE
I, Noel J. Knight (employee of owner) or (agent) of the above-described well, being first duly sworn on oath, says: That I have knowledge of the facts, statements, and matters herein contained and the log of the above-described well as filed and that the same are true and correct. So help me God.

(Signature) Noel Knight
Chase, Kansas (Address)

Subscribed AND SWORN to before me this 30th day of December, 1959

My commission expires 9-27-62
Thomas C. Dyer Notary Public.

15-007-0749-0000

BEARDMORE-BARBARA
STEWART "D" #2
SW NE SE Section 15-32S-11W
Barber County, Kansas

Drilled By: Beardmore Drilling Company
Drilling Commenced: 2-22-58
Drilling Completed: 3-1-58

Casing Record:

8-5/8" set at 216' with 140 sacks cement on 2-22-58. Cement circulated.
5-1/2" set at 3597' with 140 sacks cement on 3-1-58.

Elevations: 1518 KB
1515 DF

<u>FORMATIONS</u>	<u>DEPTH</u>
Cellar	5
Sand	120
Shale and Shells	216
Red Bed-Gyp. -Sand-Shale	840
Shale and Lime	1590
Rotary Total Depth	3602

TOPS

Snyderville Sand 3589

RECEIVED
STATE CORPORATION COMMISSION
DEC 1 1959
12-1-59
CONSERVATION DIVISION
Wichita, Kansas

CORE #1 3589-3602 Recovered 12'

DST #1 3591-3602 Shut in 20 min., open 1 hr., shut in 20 min., weak blow throughout. Recovered 30' slightly oil cut mud, 60' thin mud. IBHP 1385, FBHP 1060, IF 25, FF 40, Hydrostatic pressure 2020, Temperature 92°.

STATE OF KANSAS)
) ss
COUNTY OF SEDGWICK)

I, the undersigned, being duly sworn on oath state that the above and within statement is a true and correct record and log of the well drilled on the location above described, to the best of my knowledge and belief.

Ed Beardmore

Subscribed and sworn to before me this 13th day of March, 1958.

Leonard P. Tolle
Leonard P. Tolle-Notary Public

My Commission Expires:
January 28, 1960