

15135-21767-0000

STATE OF KANSAS  
STATE CORPORATION COMMISSION

WELL PLUGGING RECORD

Give All Information Completely  
Make Required Affidavit  
Mail or Deliver Report to  
Conservation Division  
State Corporation Comm.  
245 North Water  
Wichita, KS 67202

Ness County, Sec. 35 Twp. 18S Rge. 21W ~~21W~~  
Location as "NE/CNW 1/4 SW 1/4" or footage from lines  
NW SE SE


Lease Owner George Jones  
Lease Name Ryersee Well No. 1  
Office Address 1310 Kansas State Bank Bldg., Wichita, KS  
Character of Well (Completed as Oil, Gas or Dry Hole) dry hole

Date Well completed March 2 19 80  
Application for plugging filed March 2 19 80  
Application for plugging approved March 2 19 80  
Plugging commenced March 2 19 80  
Plugging completed March 2 19 80  
Reason for abandonment of well or producing formation

If a producing well is abandoned, date of last production 19

Was permission obtained from the Conservation Division or its agents before plugging was commenced? yes

Name of Conservation Agent who supervised plugging of this well Duane Rankin, Great Bend, KS  
Producing formation Depth to top Bottom Total Depth of Well 4235  
Show depth and thickness of all water, oil and gas formations.

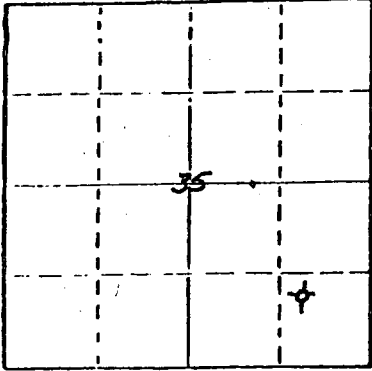

Locate well correctly on above Section Plat

OIL, GAS OR WATER RECORDS

CASING RECORD

FORMATION	CONTENT	FROM	TO	SIZE	PUT IN	PULLED OUT

Describe in detail the manner in which the well was plugged, indicating where the mud fluid was placed and the method or methods used in introducing it into the hold. If cement or other plugs were used, state the character of same and depth placed, from feet to feet for each plug set.

Plugged as follows:

Filled hole w/mud, pumped 60 sx 50/50 pozmix 4% gel thru open end drill pipe @ 660' mud to 250'; pumped 30 sx thru open end drill pipe, mud to 40'; 1/2 sx hulls & wood plug for solid bridge, pumped 10 sx to base of cellar, 5 sx in rathole, completed @ 10:30 a.m. 3-2-80 by Halliburton.  
Witnessed: Duane Rankin, State Plugger, Great Bend, Kansas  
Gary Bagby, Sterling, Kansas

RECEIVED  
STATE CORPORATION COMMISSION

(If additional description is necessary, use BACK of this sheet)

Name of Plugging Contractor Husky Drilling Co., Inc.

MAR - 6 1980

3-6-80  
CONSERVATION DIVISION  
Wichita, Kansas  
ss.

STATE OF KANSAS COUNTY OF SEDGWICK  
Jon T. Williams, Jr. (employee of owner) or (owner or operator)  
of the above-described well, being first duly sworn on oath, says: That I have knowledge of the facts, statements, and matters herein contained and the log of the above-described well as filed and that the same are true and correct. So help me God.


(Signature)

200 E. First, Suite 500, Wichita, KS 67202  
(Address)

SUBSCRIBED AND SWORN TO before me this 5th day of March, 1980

Geraldine Stewart  
Geraldine Stewart Notary Public.

My commission expires January 12, 1981

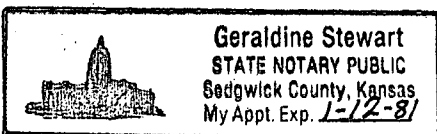



200 E. First, Suite 500  
~~800 Biting Bldg~~  
Wichita, Kansas 67202  
Phone 316 - 263-7904  
Mobile Phone 316 - 793-7859 Unit 7070

15135-21767-0000

WELL LOG-----Ryersee #1  
Located: NW SE SE of Section 35-18S-21W, Ness Co., Kansas

OWNER: George Jones  
ROTARY CONTRACTOR: Husky Drilling Co., Inc.

COMMENCED: February 24, 1980  
COMPLETED: March 2, 1980

Rotary Total Depth: 4235'

<u>Log</u>	
0 - 35	Surface soil & clay
35 - 85	Post rock & shale
85 - 265	Shale
265 - 762	Shale & sand
762 - 981	Sand
981 - 1275	Red Bed & sand strgrs.
1275 - 1337	Red Bed
1337 - 1368	Anhydrite
1368 - 2225	Shale & shells
2225 - 3780	Shale & lime
3780 - 3943	Lime
3943 - 4134	Lime & shale
4134 - 4196	Lime, shale & sand
4196 - 4235	Lime

<u>Casing Record</u>
Ran 8 jts., 8-5/8", 28#, 8V, Rge 2 used csg., tallied 264' set @ 271' KB w/175 sx 60/40 pozmix, 2% gel, 3% cc - circulated - Plug down @ 3 p.m. 2-24-80 by Halliburton

RECEIVED  
STATE CORPORATION COMMISSION

MAR - 6 1980

CONSERVATION DIVISION  
Wichita, Kansas

Plugged & Abandoned 3-2-80.