


STATE OF KANSAS
STATE CORPORATION COMMISSION

WELL PLUGGING RECORD

Give All Information Completely
Make Required Affidavit
Mail or Deliver Report to
Conservation Division
State Corporation Comm.
245 North Water
Wichita, KS 67202

Ness County. Sec. 35 Twp. 18S Rge. 21 E/W
Location as "NE/CNW 1/4 SW 1/4" or footage from lines
SW SE NW

Lease Owner Mack Oil Co.
Lease Name Mellick #A-2 Well No. _____
Office Address 908 Union Center, Wichita, Kansas 67202
Character of Well (Completed as Oil, Gas or Dry Hole)

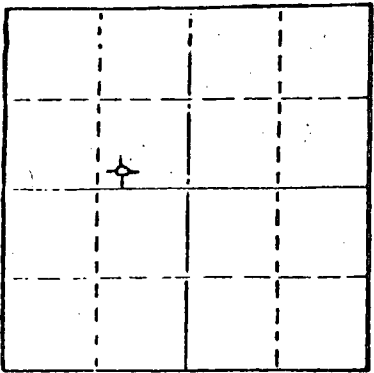

Locate well correctly on above
Section Plat

Dry Hole
Date Well completed 7-23-79 19
Application for plugging filed 7-23-79 19
Application for plugging approved 7-23-79 19
Plugging commenced 7-23-79 19
Plugging completed 7-23-79 19
Reason for abandonment of well or producing formation
Commercial quantities of oil not found
If a producing well is abandoned, date of last production 19

Was permission obtained from the Conservation Division or
its agents before plugging was commenced? Yes

Name of Conservation Agent who supervised plugging of this well Marian Schmidt, Hays, Ks.
Producing formation _____ Depth to top _____ Bottom _____ Total Depth of Well 4260'
Show depth and thickness of all water, oil and gas formations.

OIL, GAS OR WATER RECORDS

CASING RECORD

FORMATION	CONTENT	FROM	TO	SIZE	PUT IN	PULLED OUT
				8 5/8"	259'	None

Describe in detail the manner in which the well was plugged, indicating where the mud fluid
was placed and the method or methods used in introducing it into the hold. If cement or other
plugs were used, state the character of same and depth placed, from _____ feet to
_____ feet for each plug set.

- Plug @ 720' w/70 sx.
- Plug @ 250' w/40 sx.
- Plug @ 40' w/10 sx.
- Rat Hole 5 sx.

RECEIVED
STATE CORPORATION COMMISSION
7-27-79
(Sheet)
7-27-1979
CONSERVATION DIVISION
Wichita, Kansas

(If additional description is necessary, use BACK of this sheet)

Name of Plugging Contractor Rains & Williamson Oil Co., Inc.


STATE OF Kansas COUNTY OF Sedgwick, ss.
Wilson Rains, President of Rains & Williamson Oil Co. (employee of owner) or (owner or operator)
of the above-described well, being first duly sworn on oath, says: That I have knowledge of
the facts, statements, and matters herein contained and the log of the above-described well
as filed and that the same are true and correct. So help me God.

(Signature) Wilson Rains
435 Page Court, 220 W. Douglas, Wichita, Kansas 67202
(Address)

SUBSCRIBED AND SWORN TO before me this 25 day of July, 1979

Juanita M. Green
Juanita M. Green Notary Public.

My commission expires _____

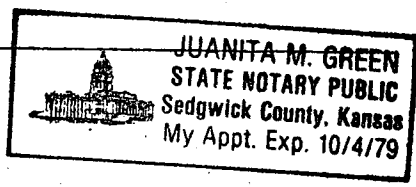

DRILLER'S LOG

15-135-21642-0000

COMPANY: Mack Oil Co.

SEC. 35 T. 18S R. 21W

WELL NAME: Mellick #A-2

LOC. SW SE NW

COUNTY: Ness

RIG NO. #8

TOTAL DEPTH 4260'

ELEVATION 2162' Gr.

COMMENCED: 7-13-79

COMPLETED: 7-23-79

CONTRACTOR: Rains & Williamson Oil Co., Inc.

CASING RECORD:

SURFACE: 8 5/8" @ 259' w/155 sx. 50/50 poz., 2% cc., 2% gel.

PRODUCTION: D&A

LOG

(Figures Indicate Bottom of Formations)

Shale	1757
Shale & Lime	2417
Lime	3960
Lime & Shale	4230
Lime	4260
<u>ROTARY TOTAL DEPTH</u>	<u>4260</u>

RECEIVED
 STATE CORPORATION COMMISSION
 JUL 27 1979
 CONSERVATION DIVISION
 Wichita, Kansas

STATE OF Kansas)
 COUNTY OF Sedgwick)

SS:

I, Wilson Rains, President of Rains & Williamson Oil Co., Inc.
 upon oath state that the above and foregoing is a true and correct copy of the log of the
Mellick #A-2 well.

Wilson Rains
 Wilson Rains

Subscribed and sworn to before me this 25 day of July, 1979.

My Appointment Expires
JOANITA M. GREEN
 STATE NOTARY PUBLIC
 Sedgwick County, Kansas
 My Appt. Exp. 10/4/79

Juanita M. Green
 Juanita M. Green