


STATE OF KANSAS
 STATE CORPORATION COMMISSION
 Give All Information Completely,
 Make Required Affidavit,
 Mail or Deliver Report to:
 Conservation Division
 State Corporation Commission
 212 No. Market
 Wichita, Kansas

WELL PLUGGING RECORD

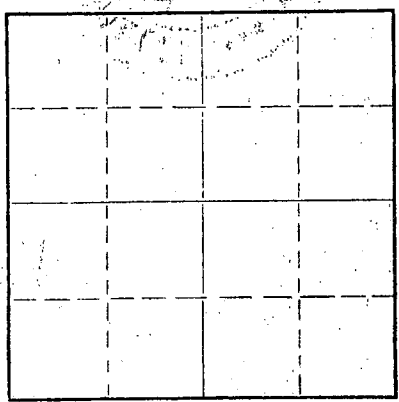

Locate well correctly on above Section Plat

Ness County, Sec. 35 Twp. 18 Rge. 21 (E) (W) x
 Location as "NE/CNW/SW" or footage from lines 150' N. of C SW SE.
 Lease Owner Imperial Oil Co.
 Lease Name Ryersee "R" Well No. #1
 Office Address Box 784, Great Bend, Kansas
 Character of Well (completed as Oil, Gas or Dry Hole)
 Date well completed _____ 19____
 Application for plugging filed Aug. 30, 1968 19____
 Application for plugging approved _____ 19____
 Plugging commenced 10-1-68 19____
 Plugging completed 10-2-68 19____
 Reason for abandonment of well or producing formation _____

If a producing well is abandoned, date of last production _____ 19____
 Was permission obtained from the Conservation Division or its agents before plugging was commenced? _____

Name of Conservation Agent who supervised plugging of this well Leo Massey
 Producing formation _____ Depth to top _____ Bottom _____ Total Depth of Well 4192' Feet
 Show depth and thickness of all water, oil and gas formations.

OIL, GAS OR WATER RECORDS

CASING RECORD

FORMATION	CONTENT	FROM	TO	SIZE	PUT IN	PULLED OUT
				5 1/2"	4188'	None
				8 5/8"	275'	

Describe in detail the manner in which the well was plugged, indicating where the mud fluid was placed and the method or methods used in introducing it into the hole. If cement or other plugs were used, state the character of same and depth placed, from _____ feet to _____ feet for each plug set.

Mixed and pumped 10 sacks cement, followed with 10 sacks gel. Mixed and pumped 15 sacks gel and displaced with 75 sacks cement.

RECEIVED
 STATE CORPORATION COMMISSION
 OCT 7 - 1968
 CONSERVATION DIVISION
 Wichita, Kansas


(If additional description is necessary, use BACK of this sheet)

Name of Plugging Contractor Southwest Casing Pulling Co.
 Address Box 364, Great Bend, Kansas

STATE OF Kansas, COUNTY OF Barton, ss.
 Southwest Casing Pulling Co. (employee of owner) or (owner or operator) of the above-described well, being first duly sworn on oath, says: That I have knowledge of the facts, statements, and matters herein contained and the log of the above-described well as filed and that the same are true and correct. So help me God.

(Signature) W. C. Spencer Sec.
 Box 364, Great Bend, Kansas
 (Address)

Subscribed and sworn to before me this 5 day of October, 1968.

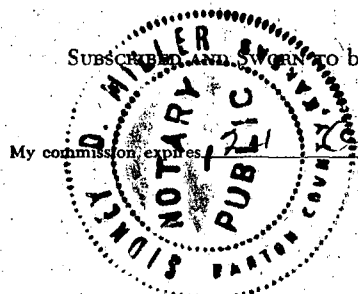

Sidney Miller
 Notary Public.