

15-077-00035-0000

STATE OF KANSAS
STATE CORPORATION COMMISSION

WELL PLUGGING RECORD

Give All Information Completely
Make Required Affidavit
Mail or Deliver Report to:
Conservation Division
State Corporation Commission
800 Bitting Building
Wichita, Kansas

Harper County, Sec. 17 Twp. 32 Rge. 9 (SW) (W)

Location as "NE/CNW/SW" or footage from lines SW SW NW

Lease Owner Aylward Drilling Company

Lease Name Holcomb Well No. 1

Office Address 813 1st Nat'l Bank Bldg. - Wichita, Kansas

Character of Well (completed as Oil, Gas or Dry Hole) Dry Hole

Date well completed September 10 19 55

Application for plugging filed September 10 19 55

Application for plugging approved September 12 19 55


Plugging commenced September 10 19 55

Plugging completed September 10 19 55

Reason for abandonment of well or producing formation Dry hole

If a producing well is abandoned, date of last production 19

Was permission obtained from the Conservation Division or its agents before plugging was commenced? Yes

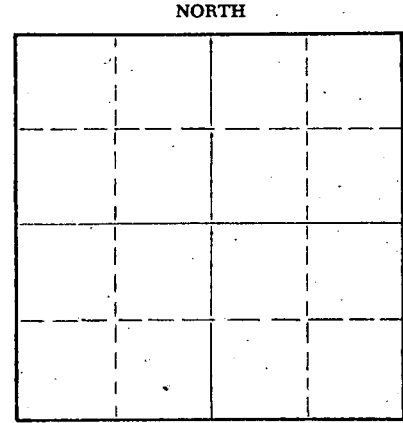

Locate well correctly on above Section Plat

Name of Conservation Agent who supervised plugging of this well M. A. Rives - Pratt, Kansas

Producing formation Depth to top Bottom Total Depth of Well Feet

Show depth and thickness of all water, oil and gas formations.

OIL, GAS OR WATER RECORDS

CASING RECORD

FORMATION	CONTENT	FROM	TO	SIZE	PUT IN	PULLED OUT
				8 5/8"	194	None

Describe in detail the manner in which the well was plugged, indicating where the mud fluid was placed and the method or methods used in introducing it into the hole. If cement or other plugs were used, state the character of same and depth placed, from feet to feet for each plug set.

Filled hole with heavy mud from T. D. (4911') to 190'; set plug with 20 sacks of cement at 190', and filled with heavy mud to 35'; set plug and run 10 sacks cement to bottom of cellar.

(If additional description is necessary, use BACK of this sheet)

Name of Plugging Contractor Aylward Drilling Company

Address 813 1st Nat'l Bank Bldg. - Wichita, Kansas

STATE OF Kansas, COUNTY OF Sedgwick, ss.

Paul W. Hesse (employee of owner) of the above-described

well, being first duly sworn on oath, says: That I have knowledge of the facts, statements, and matters herein contained and the log of the above-described well as filed and that the same are true and correct. So help me God.

(Signature) Paul W. Hesse

813 1st Nat'l Bank Bldg. - Wichita, Kansas

(Address)

SUBSCRIBED AND SWORN TO before me this 16th day of September, 19 55

My commission expires December 11, 1957

Duane Jessup - Notary Public.

PLUGGING
FILE SEC 17 T 32 R 9 W
BOOK PAGE 148 LINE 42

RECEIVED
STATE CORPORATION COMMISSION
SEP 17 1955
9-17-55
CONSERVATION DIVISION

HOLCOMB #1

Casing Record:

8-5/8" 195' cemented with 200 sks
Posmix

Company: Aylward Drilling Company
Contractor: Aylward Drilling Company

Commenced: August 20, 1955

Completed: September 10, 1955

Elevation:
1441 Kelly Bushing

Location:
SW SW NW
Section 17-32-9W
Harper County, Kansas

	From	To
Sand & Gravel	0	20
Clay	20	25
Red Rock & Red Bed	25	195
Red Rock	195	205
Red Bed & Shale	205	809
Shale & Shells	809	1015
Salt	1015	1075
Shale with lime streaks	1075	1190
Lime Shale Streaks	1190	1350
Lime-Shale	1350	1490
Lime	1490	1610
Sandy Lime	1610	1670
Lime & Shale	1670	1760
Lime	1760	1860
Lime & Shale	1860	1882
Sandy Lime with Shale	1882	1985
Lime & Shale	1985	2057
Shale & Lime	2057	2980
Sand	2980	3070
Shale & Shells	3070	3150
Shale & Lime	3150	3250
Shale & Sand	3250	3350
Shale & Lime	3350	3618
Shale & Sand	3618	3641
Lime	3641	3820
Shale & Shells	3820	3908
Lime & Shale	3908	4360
Lime	4360	4606
Lime & Shale	4606	4663
Lime, Chert, Shale	4663	4690
Lime	4690	4713
Sand & Shale	4713	4730
Shale & Sand	4730	4773
Shale & Sand	4773	4791
Sand & Shale	4791	4842
Sand & Shale	4842	4856
Dolomite & Shale	4856	4911 R.T.D.

GEOLOGICAL TOPS

Elgin Sandstone	3259
Heebner	3378
Douglas	3416
Douglas Sandstone	3438
Lansing	3612
Base Kansas City	4116
Cherokee	4285
Mississippi	4348
Kinderhook Shale	4553
Chattanooga	4588
Misener	4629
Viola	4634
Simpson	4714
Arbuckle	4858

DRILL STEM TESTS

DST #1: 3440-3450, Open 1 hour,
fair blow throughout,
Recovered 510' salt
water, FP 20-230#, SIBHP
1350#/30 mon., Hyd.
1880#/10.3# mud.

D.S.T #2: 4355-4380, Open 1 hr.
weak blow dead in 20
min., Recovered 10' m,
FP 20-28#, SIBHP 28#/
30 mon., Hyd. 2446#/10.1#
mud.

I certify that this is a true and correct copy of the above log to the best of my knowledge.

Paul W. Hesse
Paul W. Hesse

Subscribed and sworn to before me this 16TH day of SEPTEMBER, 1955.

Duane Jessup
Duane Jessup
Notary Public

My Commission Expires: December 11, 1957.

