


STATE OF KANSAS
STATE CORPORATION COMMISSION

WELL PLUGGING RECORD

Give All Information Completely
Make Required Affidavit
Mail or Deliver Report to
Conservation Division
State Corporation Comm.
245 North Water
Wichita, KS 67202

Barber County, Sec. 24 Twp. 32S Rge. 11 E/W
Location as "NE/CNW $\frac{1}{4}$ SW $\frac{1}{4}$ " or footage from lines
C E/2 NW/4 NE/4
Lease Owner Barnett Oil, Inc.
Lease Name McGuire Well No. 1
Office Address Suite 210, 260 N. Rock Road
Character of Well (Completed as Oil, Gas or Dry Hole)

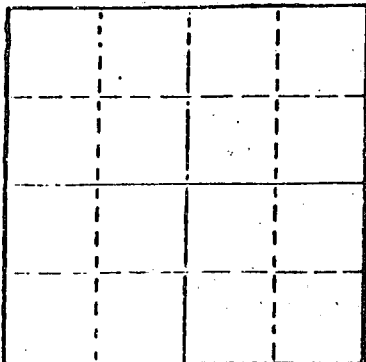

Locate well correctly on above
Section Plat

Dry Hole
Date Well completed 4/4/79 19
Application for plugging filed Verbal 19
Application for plugging approved Verbal 19
Plugging commenced 4/4/79 19
Plugging completed 4/4/79 19
Reason for abandonment of well or producing formation
D & A

If a producing well is abandoned, date of last production 19

Was permission obtained from the Conservation Division or
its agents before plugging was commenced? Yes

Name of Conservation Agent who supervised plugging of this well Verbal
Producing formation Depth to top Bottom Total Depth of Well
Show depth and thickness of all water, oil and gas formations.

OIL, GAS OR WATER RECORDS

CASING RECORD

FORMATION	CONTENT	FROM	TO	SIZE	PUT IN	PULLED OUT
				8 5/8"	251'	-0-

Describe in detail the manner in which the well was plugged, indicating where the mud fluid
was placed and the method or methods used in introducing it into the hold. If cement or other
plugs were used, state the character of same and depth placed, from _____ feet to
_____ feet for each plug set.

40 sacks @ 240'
125 Sacks @ 40'
3 sacks in rat hole.

(If additional description is necessary, use BACK of this sheet)

Name of Plugging Contractor Eagle Drilling, Inc.

STATE OF Kansas COUNTY OF Sedgwick, ss.
Robert L. Eisel (employee of owner) or (owner or operator)

of the above-described well, being first duly sworn on oath, says: That I have knowledge of
the facts, statements, and matters herein contained and the log of the above-described well
as filed and that the same are true and correct. So help me God.

(Signature) Robert L. Eisel
Suite 210, 260 N. Rock Road, Wichita, Ks. 67206
(Address)

SUBSCRIBED AND SWORN TO before me this 6th day of April, 19 79

My commission expires
LEOLA LYNKEY
STATE NOTARY PUBLIC
SEDGWICK COUNTY, KS.
MY APPT. EXPIRES 3-20-83

Leola Lynskey
Leola Lynskey Notary Public.

RECEIVED
STATE CORPORATION COMMISSION
APR 10 1979
4-10-79
CONSERVATION DIVISION
Wichita, Kansas

DRILLER'S LOG

Operator: Barnett Oil, Inc.
 Lease Name: McGuire #1
 Spot Location: C E/2 NW/4 NE/4
 Sec: 24-32S-11W
 County, State: Barber County, Kansas

Commenced: 3/27/79
 Completed: 4/4/79

Surface Casing: 6 jts. used 8 5/8", 28#, 1.w.
8v thd, rge 3 casing, set @ 251' with 200 sacks
common, 3% cc, 2% gel.

<u>FORMATION</u>	<u>DEPTH</u>
Red Bed	0- 251
Red Bed & Shale	251- 770
Shale	770-1470
Lime & Shale	1470-1505
Shale & Lime	1505-1825
Lime & Shale	1825-2385
Shale & Lime	2385-3635
Lime & Shale & Sand	3635-3805
Shale & Lime	3805-3945
Lime	3945-4495
	4495-TD

I do hereby certify that the foregoing statements are true and correct to the best of my knowledge and belief.

EAGLE DRILLING, INC.

Robert L. Eisel
 Robert L. Eisel

STATE RECEIVED
 CORPORATION COMMISSION

APR 10 1979
 4-10-79
 CONSERVATION DIVISION
 Wichita, Kansas 79

STATE OF KANSAS)
 COUNTY OF SEDGWICK) ss:

Subscribed and sworn to before me this 6th day of April, 1979.

LEOLA LYNKEY
 STATE APPOINTMENT EXPIRES 3/20/83
 SEDGWICK COUNTY, KS
 MY APPT. EXPIRES 3-20-83

Leola Lynskey
 Notary Public Leola Lynskey