

STATE OF KANSAS
STATE CORPORATION COMMISSION

Give All Information Completely
Make Required Affidavit
Mail or Deliver Report to:
Conservation Division
State Corporation Commission
211 No. Broadway
Wichita, Kansas

WELL PLUGGING RECORD

Harper County. Sec. 20 Twp. 33 Rge. 9 (E) W (W)

Location as "NE/CNW*SW*" or footage from lines NE NW SE

Lease Owner Mull Drlg. Co. Inc.

Lease Name Loesch Well No. 1

Office Address 670 N. 4th. Natl. Bank Bldg. Wichita, Kans.

Character of Well (completed as Oil, Gas or Dry Hole) Dry Hole

Date well completed 4-17-60 19

Application for plugging filed 4-17-60 19

Application for plugging approved 4-17-60 19


Plugging commenced 12:00 A.M. 4-18-60 19

Plugging completed 4:00 A.M. 4-18-60 19

Reason for abandonment of well or producing formation Non Productive

If a producing well is abandoned, date of last production 19

Was permission obtained from the Conservation Division or its agents before plugging was commenced? Yes

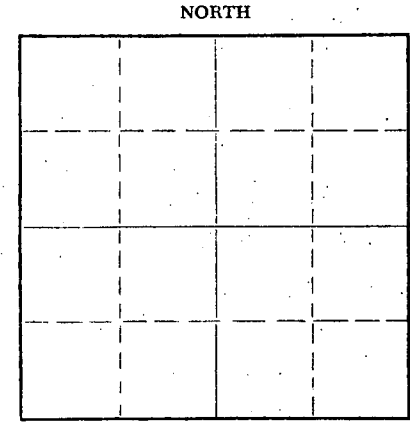

Locate well correctly on above Section Plat

Name of Conservation Agent who supervised plugging of this well Fred Hampel

Producing formation Depth to top Bottom Total Depth of Well 4850' Feet

Show depth and thickness of all water, oil and gas formations.

OIL, GAS OR WATER RECORDS

CASING RECORD

FORMATION	CONTENT	FROM	TO	SIZE	PUT IN	PULLED OUT

Describe in detail the manner in which the well was plugged, indicating where the mud fluid was placed and the method or methods used in introducing it into the hole. If cement or other plugs were used, state the character of same and depth placed, from feet to feet for each plug set.

Hole filled with drilling mud to depth within 180' of top of hole.
#1 Plug pushed to this depth with drill pipe, 1/2 sack hulls added on top of plug. 20 sacks cement put on top of plug through drill pipe.
Hole then filled within 40' of top of hole, 1/2 sack hulls put on top of #2 plug, and 10 sacks cement put on top of hulls. This filled hole with cement. To complete plugging, a bridge was formed in rat hole and 2 sacks cement put in rat hole.

RECEIVED
STATE CORPORATION COMMISSION

APR 26 1960

CONSERVATION DIVISION
Wichita, Kansas

(If additional description is necessary, use BACK of this sheet)

Name of Plugging Contractor Co. Tools

Address 670 N. 4th. Natl. Bank Bldg. Wichita, Kansas

STATE OF Kansas, COUNTY OF Sedgwick, ss.

Joseph O. Butts (employee of owner) or (owner or operator) of the above-described well, being first duly sworn on oath, says: That I have knowledge of the facts, statements, and matters herein contained and the log of the above-described well as filed and that the same are true and correct. So help me God.

(Signature) Joseph O. Butts
817 N. Main - Med. Lodge, Kans.
(Address)

SUBSCRIBED AND SWORN TO before me this 25th day of April, 1960

Ethel Zimmerman
Ethel Zimmerman Notary Public.

My commission expires January 28, 1961.

ROTARY DRILLERS LOG

COMPANY: Mull Drilling Co., Inc. Et Al
Wichita, Kansas

ROTARY DRILLING COMMENCED: 4/5/60

CONTRACTOR: Mull Drilling Co., Inc.
Wichita, Kansas

ROTARY DRILLING COMPLETED: 4/18/60

CASING RECORD: Set 200' of 8 5/8" csg.
w/135 sax cmt.
D & A

LOCATION: Loesch #1
NE NW SE 20-33S-9W
Harper County, Kansas

(Figures indicate bottom of formation - measurements from top of Rotary Bushing.)

600'	Red Rock
1400'	Shale & Shells
1612'	Lime & Shale
1760'	Lime
3095'	Lime & Shale
3880'	Sandy Lime & Shale
4069'	Lime w/Shale
4273'	Lime
4470'	Lime & Shale
4611'	Mississippi chert
4660'	Cherty Lime w/Shale
4725'	Kinderhook Shale
4746'	Kinerhook & Chattanooga Shale
4782'	Lime s/Shale
4816'	Viola - Cherty Lime
4850'	Simpson - Total depth

RECEIVED
STATE CORPORATION COMMISSION
APR 26 1960
CONSERVATION DIVISION
Wichita, Kansas


I hereby certify that this is a true and correct copy of the above log to the best of my knowledge.

MULL DRILLING COMPANY, INC.

Joseph B. Brungardt, Jr.
Joseph B. Brungardt, Jr.

STATE OF KANSAS)
) SS
COUNTY OF SEDGWICK)

Subscribed and sworn to before me this 25th day of April, 1960.

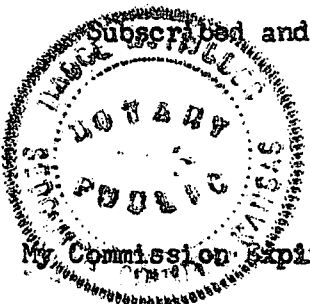

Mary N. Miller