

Give All Information Completely
Make Required Affidavit
Mail or Deliver Report to:
Conservation Division
State Corporation Commission
211 No. Broadway
Wichita, Kansas

WELL PLUGGING RECORD

Harper County, Sec. 16 Twp. 33S Rge. (E) 9 (W)

Location as "NE/CNW/SW" or footage from lines C NW SW

Lease Owner Rains & Williamson Oil Company

Lease Name Loesch Well No. 1

Office Address 1425 Wichita Plaza Building, Wichita, Kansas

Character of Well (completed as Oil, Gas or Dry Hole) Dry Hole

Date well completed 3-19 1966

Application for plugging filed 3-19 1966

Application for plugging approved 3-19 1966


Plugging commenced 3-19 1966

Plugging completed 3-19 1966

Reason for abandonment of well or producing formation no oil or gas found in commercial quantities

If a producing well is abandoned, date of last production 19

Was permission obtained from the Conservation Division or its agents before plugging was commenced? YES

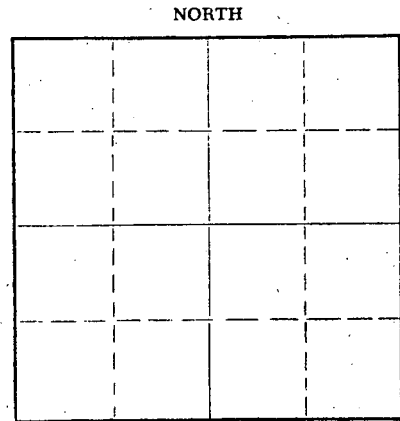

Locate well correctly on above Section Plat

Name of Conservation Agent who supervised plugging of this well Archie Elving, Pratt, Kansas

Producing formation Depth to top Bottom Total Depth of Well 4825 Feet

Show depth and thickness of all water, oil and gas formations.

OIL, GAS OR WATER RECORDS

CASING RECORD

Table with 7 columns: FORMATION, CONTENT, FROM, TO, SIZE, PUT IN, PULLED OUT. Row 1: SIZE 8-5/8", PUT IN 209.70.

Describe in detail the manner in which the well was plugged, indicating where the mud fluid was placed and the method or methods used in introducing it into the hole. If cement or other plugs were used, state the character of same and depth placed, from feet to feet for each plug set.

Set solid bridge at 200'. Cement 25 sacks. Mud back to 40'.
Set solid bridge, cement with 10 sacks.

RECEIVED
STATE CORPORATION COMMISSION
MAR 25 1966
CONSERVATION DIVISION
Wichita, Kansas

(If additional description is necessary, use BACK of this sheet)

Name of Plugging Contractor Rains & Williamson O-1 Company

Address 1425 Wichita Plaza Building, Wichita, Kansas

STATE OF Kansas, COUNTY OF Sedgwick, ss. Wilson Rains (employee of owner) or (owner or operator) of the above-described well, being first duly sworn on oath, says: That I have knowledge of the facts, statements, and matters herein contained and the log of the above-described well as filed and that the same are true and correct. So help me God.

(Signature) Wilson Rains
Wilson Rains, Partner
1425 Wichita Plaza Bldg., Wichita, Ks.
(Address)

SUBSCRIBED AND SWORN TO before me this 23rd day of March, 1966

My commission expires March 3, 1970

Mary J. Brown
Notary Public.

ROTARY DRILLING LOG

OPERATOR: Rains & Williamson Oil Co.
#1 Loesch
C NW SW Section 16-33S-9W
Harper County, Kansas

CONTRACTOR: Rains & Williamson Oil Co.
Commenced: 3-4-66
Completed: 3-19-66
Remarks: Set 209.70' of 8-5/8" surface pipe with 185 sacks of GL3.

FORMATIONS:

Red Rock	43°
Red Bed	130°
Shale	1225°
Shale & Red Bed	1315°
Anhydrite	1328°
Shale & Lime	1530°
Lime & Shale	1900°
Shale & Lime	3655°
Sand	3818°
Shale & Lime	4035°
Lime	4325°
Lime & Shale	4390°
Lime	4434°
Lime & Cherty	4505°
Lime	4567°
Lime & Shale	4610°
Shale & Lime	4680°
Shale	4707°
Lime	4785°
Sand	4825°

Rotary Total Depth (D&A) 4825°

RECEIVED
STATE CORPORATION COMMISSION

MAR 25 1966

CONSERVATION DIVISION
Wichita, Kansas

We certify the above log is true and correct to the best of our knowledge and belief.

RAINS & WILLIAMSON OIL COMPANY

Wilson Rains
Wilson Rains, Partner

Subscribed and sworn to before me, a Notary Public in and for the State of Kansas, County of Sedgwick, this 23rd day of March, 1966.

My Commission Expires: March 3, 1970

Mary J. Brown
Mary J. Brown Notary Public