


STATE OF KANSAS
STATE CORPORATION COMMISSION

Form CP-4

Give All Information Completely
Make Required Affidavit
Mail or Deliver Report to:
Conservation Division
State Corporation Commission
211 No. Broadway
Wichita, Kansas

WELL PLUGGING RECORD

NORTH

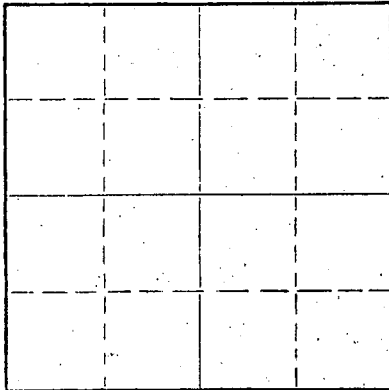

Locate well correctly on above
Section Plat

Harper

County. Sec. 14 Twp. 33S Rge. (E) 9 (W)

Location as "NE/CNW&SW¼" or footage from lines. C SE SE

Lease Owner Kimbark Operating Co.

Lease Name Silcott

Well No. 2

Office Address 201 University Blvd. Denver, Colol

Character of Well (completed as Oil, Gas or Dry Hole) Dry

Date well completed 6/6/67 19 67

Application for plugging filed 6/65/ 19 67

Application for plugging approved 6/9 19 67

Plugging commenced 6/9 19 67

Plugging completed 6/9/67 19

Reason for abandonment of well or producing formation

If a producing well is abandoned, date of last production 19

Was permission obtained from the Conservation Division or its agents before plugging was commenced? yes

Name of Conservation Agent who supervised plugging of this well A. Elving Box 248 Pratt, Kansas

Producing formation Depth to top Bottom Total Depth of Well 4520 Feet

Show depth and thickness of all water, oil and gas formations.

OIL, GAS OR WATER RECORDS

CASING RECORD

FORMATION	CONTENT	FROM	TO	SIZE	PUT IN	PULLED OUT
		0	226	8 5/8"	7jts.	0

Describe in detail the manner in which the well was plugged, indicating where the mud fluid was placed and the method or methods used in introducing it into the hole. If cement or other plugs were used, state the character of same and depth placed, from feet to feet for each plug set.

Set 1st Plug @ 225' w/1 dry sax and ½ sax hulls and 24 sax. fill w/ heavy mud to 40'

Set 2nd plug w/ 1sax. dry and ½ sax. hulls and 7 sax. bridge rat hole w/2 sax.

RECEIVED
STATE CORPORATION COMMISSION

JUN 16 1967

CONSERVATION DIVISION
Wichita, Kansas

(If additional description is necessary, use BACK of this sheet)

Name of Plugging Contractor Gabbert-Jones

Address 830 Sutton Place Wichita, Kansas

STATE OF COLORADO, COUNTY OF DENVER, ss. W. K. Arbuckle

(employee of owner) or (owner or operator) of the above-described well, being first duly sworn on oath, says: That I have knowledge of the facts, statements, and matters herein contained and the log of the above-described well as filed and that the same are true and correct. So help me God.

(Signature) W. K. Arbuckle

201 University Blvd. Denver, Colo.

(Address)

SUBSCRIBED AND SWORN TO before me this 15th day of Juen, 19 67

My commission expires Jan. 28, 1968

Barbara J. Dossan
Notary Public.

GABBERT-JONES, INC.
WICHITA, KANSAS
DRILLERS' WELL LOG

SILCOTT #2
SE SE SECTION 14-33S-9W
HARPER COUNTY, KANSAS

COMMENCED: MAY 26, 1967
COMPLETED: JUNE 7, 1967

OPERATOR - KIMBARK OPERATING CO.

DEPTH		FORMATION	REMARKS
FROM	TO		
0	95	RED ROCK	
95	226	RED BED	RAN 7 JOINTS 8-5/8" CASING, SET @ 226' w/150 SACKS CEMENT.
226	280	RED BED	
280	1325	RED BED AND SHALE	
1325	1355	ANHYDRITE	
1355	1425	SHALE AND SHELLS	
1425	1730	LIME AND SHALE	
1730	1910	LIME	
1910	3075	LIME AND SHALE	
3075	3200	LIME	
3200	3380	LIME AND SHALE	
3380	3840	SANDY SHALE	
3840	4011	LIME AND SHALE	
4011	4521	LIME	
4521	TD		DRY AND ABANDONED.

I, E. E. HALL, CERTIFY THIS IS A CORRECT COPY OF THE DRILLERS' LOG FOR THE WELL DRILLED IN THE SE SE SECTION 14-33S-9W, HARPER COUNTY, KANSAS, TO THE BEST OF MY KNOWLEDGE AND BELIEF.

E. E. Hall
E. E. HALL

STATE OF KANSAS)
COUNTY OF SEDGWICK) SS

BEFORE ME, THE UNDERSIGNED, A NOTARY PUBLIC WITHIN AND FOR SAID COUNTY AND STATE, ON THIS 13TH DAY OF JUNE, 1967, PERSONALLY APPEARED E. E. HALL, TO ME PERSONALLY KNOWN TO BE THE IDENTICAL PERSON WHO EXECUTED THE WITHIN AND FOREGOING INSTRUMENT AND ACKNOWLEDGED TO ME THAT HE EXECUTED THE SAME AS HIS FREE AND VOLUNTARY ACT AND DEED FOR THE USES AND PURPOSES THEREIN SET FORTH.

IN WITNESS WHEREOF, I HAVE HEREUNTO SET MY HAND AND OFFICIAL SEAL THE DAY AND YEAR LAST ABOVE WRITTEN.

Barbara J. Layton
BARBARA J. LAYTON, NOTARY PUBLIC

My Commission Expires February 1, 1968.