


STATE OF KANSAS
STATE CORPORATION COMMISSION

Form CP-4

Give All Information Completely
Make Required Affidavit
Mail or Deliver Report to:
Conservation Division
State Corporation Commission
P. O. Box 17027
Wichita, Kansas 67217
NORTH

WELL PLUGGING RECORD

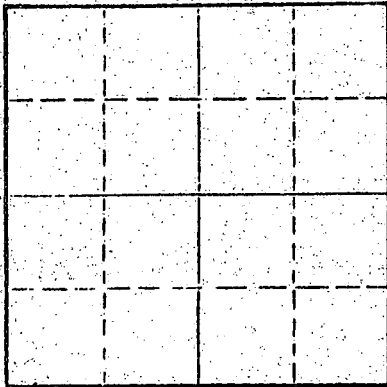

Locate well correctly on above
Section Plat

Harper County, Sec. 13 Twp. 33S Rge. (E) 9W (W)
Location as "NE/CNW/SW" or footage from lines C SW-SW
Lease Owner BANKOFF OIL COMPANY
Lease Name Babb 2479 Well No. 1
Office Address P. O. Drawer, Tulsa, Okla. 74101
Character of Well (completed as Oil, Gas or Dry Hole) Dry Hole
Date well completed 11-12-73
Application for plugging filed 11-12-73
Application for plugging approved 11-12-73
Plugging commenced 11-12-73
Plugging completed 11-12-73
Reason for abandonment of well or producing formation No commercial quantities of oil or gas encountered.
If a producing well is abandoned, date of last production 10
Was permission obtained from the Conservation Division or its agents before plugging was commenced? Yes

Name of Conservation Agent who supervised plugging of this well G. R. Biberstein
Producing formation _____ Depth to top _____ Bottom _____ Total Depth of Well 4520 Feet
Show depth and thickness of all water, oil and gas formations.

OIL, GAS OR WATER RECORDS

CASING RECORD

FORMATION	CONTENT	FROM	TO	SIZE	PUT IN	PULLED OUT
Surface Hole	Fluid	Surface	202	8-5/8"	198'	None

Describe in detail the manner in which the well was plugged, indicating where the mud fluid was placed and the method or methods used in introducing it into the hole. If cement or other plugs were used, state the character of same and depth placed, from _____ feet to _____ feet for each plug set.

Fluid to 225', plug, 40 sx cement;
Fluid to 40', plug, 10 sx cement;
Two sacks cement in rat hole.

RECEIVED
STATE CORPORATION COMMISSION
NOV 15 1973
CONSERVATION DIVISION
Wichita, Kansas

(If additional description is necessary, use BACK of this sheet)
Name of Plugging Contractor D N B DRILLING, INC.
Address 701 First Nat'l Bldg., Wichita, Kansas 67202

STATE OF KANSAS COUNTY OF _____ ss.
JAMES L. DONELSON (employee of owner) or (owner or operator) of the above-described well, being first duly sworn on oath, says: That I have knowledge of the facts, statements, and matters herein contained and the log of the above-described well as filed and that the same are true and correct. So help me God.

(Signature) James L. Donelson
701 First Nat'l Bldg., Wichita, Ks.
(Address)

SUBSCRIBED AND SWORN TO before me this 13th day of NOV. 19 73

My commission expires 8-25-76

Ella Priess
Ella Priess Notary Public.
STATE NOTARY PUBLIC
Sedgwick County, Kansas
My Com. Expires Aug. 25, 1976

DRILLERS' LOG

BANKOFF OIL COMPANY
No. 1 Babb
C SW SW, Sec. 13-33S-9W
Harper County, Kansas

Elevation: 1342 K.B.

Commenced: 10-30-73
Completed: 11-12-73

Surface: 198' of 8-5/8"
cemented w/125 sx cement,
3/8 cc. 10-18-73.

FORMATION

DEPTH

Surface Hole	0 - 205
Shale	205 - 535
Shale & Lime	535 - 1225
Lime & Shale	1225 - 2540
Shale, Lime & Sand	2540 - 2645
Lime & Shale	2645 - 2785
Lime	2785 - 2981
Lime & Shale	2981 - 3446
Sand	3446 - 3491
Lime & Shale	3491 - 3716
Shale & Sand	3716 - 3745
Sand	3745 - 3820
Shale & Lime	3820 - 3925
Lime & Shale	3925 - 3946
Lime	3946 - 4520 T.D.

RECEIVED
STATE CORPORATION COMMISSION
NOV 15 1973
CONSERVATION DIVISION
Wichita, Kansas

I do hereby certify that the foregoing statements are true and correct to the best of my knowledge and belief.

D. N. B. DRILLING, INC.

James L. Donelson
JAMES L. DONELSON

STATE OF KANSAS: ss:

Subscribed and sworn to before me, the undersigned, a Notary Public in and for said state, this 13th day of November, 1973.

My Commission Expires,
August 25, 1976

Ella Priess
Ella Priess, Notary Public

Ella Priess
STATE NOTARY PUBLIC
Sedgwick County, Kansas
My Com. Expires Aug. 25, 1976