


Give All Information Completely
Make Required Affidavit
Mail or Deliver Report to:
Conservation Division
State Corporation Commission
245 N. WATER
Wichita, Kansas 67302

WELL PLUGGING RECORD

Harper County, Sec. 6 Twp. 33S Rge. 9 (E) W (W)

Location as "NE/CNW/SW" or footage from lines 200' W. C. NW/4.3 NW/4
Lease Owner Energy Reserves Group, Inc.
Lease Name J. C. Hoath Well No. 1
Office Address 5015 N. Penn. Suite 100, Okla. City, Okla. 73112
Character of Well (completed as Oil, Gas or Dry Hole) Oil
Date well completed January 2 1974
Application for plugging filed March 27 1978
Application for plugging approved March 29 1978
Plugging commenced May 2 1978
Plugging completed May 5 1978
Reason for abandonment of well or producing formation uneconomical

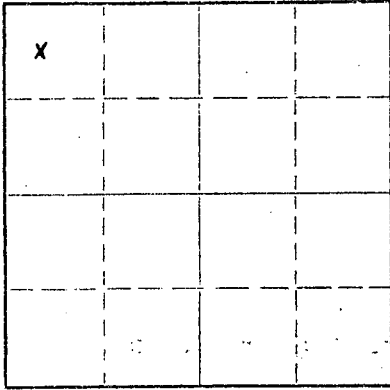

Locate well correctly on above Section Plat

If a producing well is abandoned, date of last production December 25 1977
Was permission obtained from the Conservation Division or its agents before plugging was commenced? yes

Name of Conservation Agent who supervised plugging of this well Mr. Win. T. Owen
Producing formation lower Kansas City Depth to top 3884' Bottom 4105' Total Depth of Well 4364' Feet
Show depth and thickness of all water, oil and gas formations. PBD 4200'

OIL, GAS OR WATER RECORDS

CASING RECORD

FORMATION	CONTENT	FROM	TO	SIZE	PUT IN	PULLED OUT
Topeka		3024'	3351'	8 5/8	260'	None
Douglas		3409'	3713'	5 1/2	4341'	3425'
Kansas City		3884'	4105'			
Cherokee		4250'	4321'			
Mississippi		4321'	4364'			

Describe in detail the manner in which the well was plugged, indicating where the mud fluid was placed and the method or methods used in introducing it into the hole. If cement or other plugs were used, state the character of same and depth placed, from _____ feet to _____ feet for each plug set.
Pumped bottom plug with 40 sks. of common cement. Mix one sk. of Halls with first 10 sks. of cement. Plug from 4089' to top of 3878'.

Start pulling 3425' of 5 1/2" casing. Pull casing to spot surface casing with 50 sks. of common cement, 25 sks. out and 25 sks. in surface pipe. Spotted drill mud from surface pipe plug to top plug. Run top plug with 10 sks. of cement with plate welded on top of casing.

RECEIVED
STATE CORPORATION COMMISSION

MAY 18 1978

CONSERVATION DIVISION
Wichita, Kansas

(If additional description is necessary, use BACK of this sheet)

Name of Plugging Contractor Sargent's Casing Pulling Service
Address P. O. Box 506, Liberal, Kansas 67901

STATE OF Oklahoma, COUNTY OF Oklahoma, ss.

(employee of owner) or (owner or operator) of the above-described well, being first duly sworn on oath, says: That I have knowledge of the facts, statements, and matters herein contained and the log of the above-described well as filed and that the same are true and correct. So help me God.

(Signature) *Dona W. Vaughn*

(Address)

SUBSCRIBED AND SWORN TO before me this 17 day of May 1978

My commission expires February 28, 1982

[Signature]
Notary Public

