

STATE OF KANSAS  
STATE CORPORATION COMMISSION  
CONSERVATION DIVISION  
P. O. BOX 17027  
WICHITA, KANSAS 67217

WELL PLUGGING RECORD

Harper County, Sec. 33 Twp. 33 Rge. (E) 8 (W)

Location as "NE/CNW/SE" or footage from lines E/2 SW SW

Lease Owner Robinson Oil Company

Lease Name Short "B" Well No. 1

Office Address 340 R. H. Garvey Bldg., Wichita, Kansas 67202

Character of Well (completed as Oil, Gas or Dry Hole) gas

Date well completed Oct. 18 1974

Application for plugging filed Oct. 8 1975

Application for plugging approved 19


Plugging commenced Oct. 16 1975

Plugging completed Oct. 20 1975

Reason for abandonment of well or producing formation no longer needed

If a producing well is abandoned, date of last production 19

Was permission obtained from the Conservation Division or its agents before plugging was commenced? YES

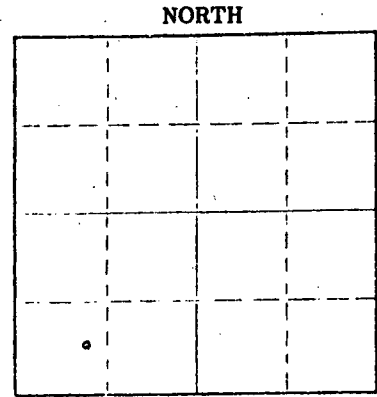

Locate well correctly on above Section Plat

Name of Conservation Agent who supervised plugging of this well G. R. Biberstein

Producing formation \_\_\_\_\_ Depth to top \_\_\_\_\_ Bottom \_\_\_\_\_ Total Depth of Well 4680 Feet

Show depth and thickness of all water, oil and gas formations.

OIL, GAS OR WATER RECORDS

CASING RECORD

FORMATION	CONTENT	FROM	TO	SIZE	PUT IN	PULLED OUT
			215'	8 5/8"	215'	none
			4675'	4 1/2"	4675'	3893.37

Describe in detail the manner in which the well was plugged, indicating where the mud fluid was placed and the method or methods used in introducing it into the hole. If cement or other plugs were used, state the character of same and depth placed, from \_\_\_\_\_ feet to \_\_\_\_\_ feet for each plug set.

Sanded back to 4100' and dumped 4 sacks of cement.

Set 10' rock bridge at 300'. Plugged well with 5 yards of ready mix cement.

Name of Plugging Contractor PIPE PULLERS, INC. (If additional description is necessary, use BACK of this sheet)

Address Box 128, Ellinwood, Kansas 67526

STATE OF KANSAS COUNTY OF BARTON ss. Evelyn Roth

(employee of owner) or (owner-operator) of the above-described well, being first duly sworn on oath, says: That I have knowledge of the facts, statements, and matters herein contained and the log of the above-described well as filed and that the same are true and correct. So help me God.

(Signature) Evelyn Roth Ellinwood, Kansas

(Address)

SUBSCRIBED AND SWORN TO before me this 28th day of October, 1975

My commission expires

JENNY KASSELMAN  
NOTARY PUBLIC  
BARTON COUNTY, KANSAS  
MY COMM. EXP. JULY 16, 1978

Jenny Kasselmann Notary Public.

RECEIVED  
STATE CORPORATION COMMISSION

OCT 29 1975

CONSERVATION DIVISION  
Wichita, Kansas

WELL LOG  
Short B #1  
E/2 SW SW 33-33-8W  
Harper County, Kansas

Name of Operator: Robinson Oil Co.  
300 West Douglas - Suite 355  
Wichita, Kansas 67202

Date Completed: October 18, 1974

<u>FROM</u>	<u>TO</u>	
0	1102	Red Bed & Shale
1102	1290	Shale
1290	3765	Lime & Shale
3765	3863	Sand
3863	4031	Lime & Shale
4031	4680	Lime
4680		Total Depth

RECEIVED  
STATE CORPORATION COMMISSION


OCT 9 1975

CONSERVATION DIVISION  
Wichita, Kansas

STATE OF KANSAS

COUNTY OF BARTON ss

Gary L. Hawk, Secretary of Sweetman Drilling, Inc., being first duly sworn on oath says: That I have knowledge of the facts, statements and matters herein contained and the log of the above described well as filed and that the same are true and correct.

  
Gary L. Hawk

Subscribed and sworn before me this 23rd day of October, 1974.

  
Notary Public Barton County

My Commission Expires 7-10-77

