

STATE OF KANSAS  
STATE CORPORATION COMMISSION

15-077-20754-0000

WELL-PLUGGING RECORD

Give All Information Completely  
Make Required Affidavit  
Mail or Deliver Report to  
Conservation Division  
State Corporation Comm.  
245 North Water  
Wichita, KS 67202

Harper County, Sec. 6 Twp. 32S Rge. 9W E/W  
Location as "NE/CNW/SW" or footage from lines  
140' W C NE SE


Lease Owner PICKRELL DRILLING COMPANY  
Lease Name Hogard "B" Well No. 1  
Office Address 205 Litwin Bldg. Wichita, Kansas 67202  
Character of Well (Completed as Oil, Gas or Dry Hole)  
DRY HOLE

Date Well completed 11/30/81 19  
Application for plugging filed 11/30/81 19  
Application for plugging approved 11/30/81 19  
Plugging commenced 11/30/81 19  
Plugging completed 11/30/81 19  
Reason for abandonment of well or producing formation  
DRY HOLE

If a producing well is abandoned, date of last production 19

Was permission obtained from the Conservation Division or its agents before plugging was commenced? Yes

Name of Conservation Agent who supervised plugging of this well Maurice Leslie  
Producing formation \_\_\_\_\_ Depth to top \_\_\_\_\_ Bottom \_\_\_\_\_ Total Depth of Well 4450  
Show depth and thickness of all water, oil and gas formations.

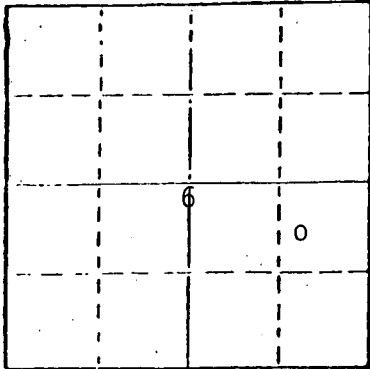

Locate well correctly on above Section Plat

OIL, GAS OR WATER RECORDS

CASING RECORD

FORMATION	CONTENT	FROM	TO	SIZE	PUT IN	PULLED OUT
				8 5/8"	208'	None

Describe in detail the manner in which the well was plugged, indicating where the mud fluid was placed and the method or methods used in introducing it into the hold. If cement or other plugs were used, state the character of same and depth placed, from \_\_\_\_\_ feet to \_\_\_\_\_ feet for each plug set.

50 Sx @ 620'  
40 Sx @ 200'  
10 Sx @ 40'  
10 Sx in rathole  
Comp at 12:15 p.m. 11/30/81


(If additional description is necessary, use BACK of this sheet)

Name of Plugging Contractor Allied Cementing

STATE OF KANSAS COUNTY OF SEDGWICK, ss.  
C. W. SEBITS (employee of owner) or (owner or operator)  
of the above-described well, being first duly sworn on oath, says: That I have knowledge of the facts, statements, and matters herein contained and the log of the above-described well as filed and that the same are true and correct. So help me God.

(Signature)

205 Litwin Bldg., Wichita, Kansas 67202  
(Address)

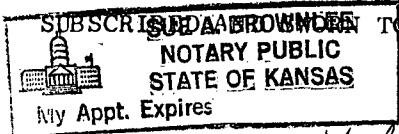

TO before me this 4 day of December, 1981

Sue A. Brumley  
Notary Public.

RECEIVED  
STATE CORPORATION COMMISSION  
DEC - 7 1981  
12-7-81  
CONSERVATION DIVISION  
Wichita, Kansas