

15-01520127-0000 P

STATE OF KANSAS
STATE CORPORATION COMMISSION

Form CP-4


Give All Information Completely
Make Required Affidavit
Mail or Deliver Report to:
Conservation Division
State Corporation Commission
212 No. Market
Wichita, Kansas

WELL PLUGGING RECORD

Butler County, Sec. ³⁴ ~~24~~ Twp. 25S Rge. 3 (E) (W)

Location as "NE/CNW/SW" or footage from lines SE SE NE
Lease Owner Commercial Oil Company
Lease Name Miller # 1 Well No. 1
Office Address 5332 North Broadway
Character of Well (completed as Oil, Gas or Dry Hole) Dry hole
Date well completed Feb. 19, 1968 19
Application for plugging filed Feb. 19, 1968 19
Application for plugging approved Feb. 19, 1968 19
Plugging commenced Feb. 19, 1968 19
Plugging completed Feb. 19, 1968 19
Reason for abandonment of well or producing formation Dry hole

If a producing well is abandoned, date of last production _____ 19
Was permission obtained from the Conservation Division or its agents before plugging was commenced? yes

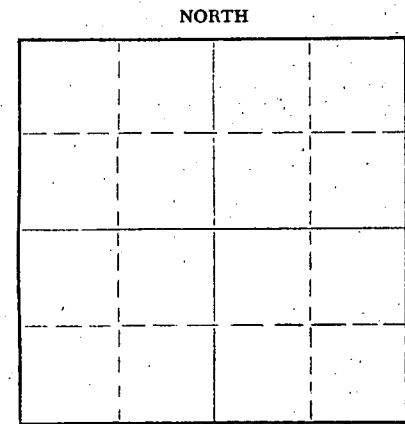

Locate well correctly on above Section Plat

Name of Conservation Agent who supervised plugging of this well Ted Dewey

Producing formation _____ Depth to top _____ Bottom _____ Total Depth of Well 2760 Feet
Show depth and thickness of all water, oil and gas formations.

OIL, GAS OR WATER RECORDS

CASING RECORD

FORMATION	CONTENT	FROM	TO	SIZE	PUT IN	PULLED OUT
				8 5/8	200	none

Describe in detail the manner in which the well was plugged, indicating where the mud fluid was placed and the method or methods used in introducing it into the hole. If cement or other plugs were used, state the character of same and depth placed, from _____ feet to _____ feet for each plug set.

~~Mud to 225~~ Mud to 205 ft. / set botton plug at 205 1/2 sx hulls on top and 20 sx cement. Mud to 30 ft. w/plug 1/2 sx hulls and 8 sx cenent. 2 sx cement in rat hole at 30 feet.

RECEIVED
STATE CORPORATION COMMISSION
MAR 7 - 1968
CONSERVATION DIVISION
Wichita, Kansas

(If additional description is necessary, use BACK of this sheet)
Name of Plugging Contractor Serobee Drilling Co., Inc.
Address 5301 North Broadway, Wichita, Kansas 67219

STATE OF Kansas, COUNTY OF Sedgwick, ss.

Paul S. Septer (employee of owner) or (owner or operator) of the above-described well, being first duly sworn on oath, says: That I have knowledge of the facts, statements, and matters herein contained and the log of the above-described well as filed and that the same are true and correct. So help me God.

(Signature) Paul S. Septer

(Address) _____

SUBSCRIBED AND SWORN TO before me this 4th day of March, 1968

My commission expires June 27, 1968

Notary Public.

9

COMPANY Serobee Drilling Co.

SEC. 34 25S 3E
 LOC. SE SE NE

FARM Miller

NO. 1

15015-20127-0000

Butler

TOTAL DEPTH @ 2760


COUNTY

COMM. 2-12-68

COMP. 2-19-68

KANSAS

SHOT OR TREATED

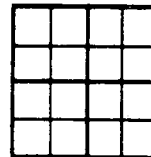

CONTRACTOR Serobee Drilling Co., Inc.

ISSUED

CASING

20	10	
15	8	5/8" 200 w/ 185 sacks cement
12	6	
13	5	

ELEVATION

PRODUCTION D & A

FIGURES INDICATE BOTTOM OF FORMATIONS

0	-	190	Lime
190	-	200	Cement
200	-	445	Lime
445	-	1400	S/L
1400	-	2260	Shale & Lime
2260	-	2416	Lime
2416	-	2706	Lime & Shale
2706	-	2760	Chert & Lime

Geological Tops

K C	2260
B K C	2416
Miss. Chert	2706
T D	2760

I certify the above to be a true and correct copy of the geological tops and driller's log to the best of my knowledge and belief.

Sincerely,

Paul S. Septa

Paul S. Septa

RECEIVED
 STATE CORPORATION COMMISSION
 MAR 14 1968
 CONSERVATION DIVISION
 Wichita, Kansas