

STATE OF KANSAS
STATE CORPORATION COMMISSION


Give All Information Completely
Make Required Affidavit
Mail or Deliver Report to:
Conservation Division
State Corporation Commission
211 No. Broadway
Wichita, Kansas

WELL PLUGGING RECORD

Barber County. Sec. 20 Twp. 31 Rge. 14 (XXX) (W)

Location as "NE/CNWxSWx" or footage from lines. SE SE SW
Lease Owner Eli Wilkerson
Lease Name Skinner Well No. 1
Office Address 11th Floor Philtower Bldg., Tulsa, Oklahoma
Character of Well (completed as Oil, Gas or Dry Hole) oil well
Date well completed 19____
Application for plugging filed 10-11-65 19
Application for plugging approved 10-13-65 19
Plugging commenced 10-15-65 19
Plugging completed 10-22-65 19
Reason for abandonment of well or producing formation depleted

NORTH

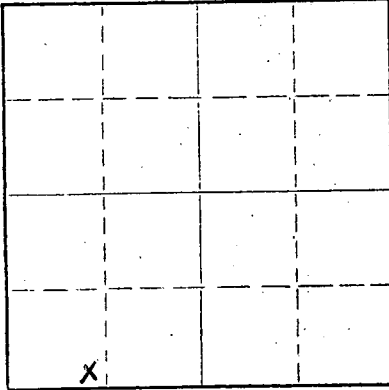

Locate well correctly on above Section Plat

If a producing well is abandoned, date of last production 19____
Was permission obtained from the Conservation Division or its agents before plugging was commenced? yes

Name of Conservation Agent who supervised plugging of this well Archie Elving
Producing formation _____ Depth to top _____ Bottom _____ Total Depth of Well 4770 Feet
Show depth and thickness of all water, oil and gas formations.


OIL, GAS OR WATER RECORDS

CASING RECORD

FORMATION	CONTENT	FROM	TO	SIZE	PUT IN	PULLED OUT
				8 5/8	No record	
				5 1/2	4770	3394

Describe in detail the manner in which the well was plugged, indicating where the mud fluid was placed and the method or methods used in introducing it into the hole. If cement or other plugs were used, state the character of same and depth placed, from _____ feet to _____ feet for each plug set.

Had plug set at 4400' and perforated at 4375'.
Fill hole with chat from 4400' to 4360' and dump 5 sacks cement.
Set 10' rock bridge from 300' to 290' and dump 25 sacks cement.
Mud hole to 40', rock bridge to 30' and dump 10 sacks cement.

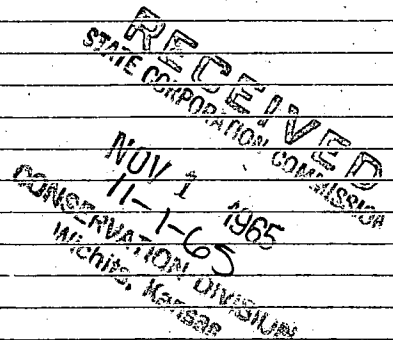

(If additional description is necessary, use BACK of this sheet)
Name of Plugging Contractor Flint Engineering & Construction Company
Address Box 950, El Dorado, Kansas

STATE OF KANSAS, COUNTY OF BUTLER, ss.

(employee of owner) or (owner or operator) of the above-described well, being first duly sworn on oath, says: That I have knowledge of the facts, statements, and matters herein contained and the log of the above-described well as filed and that the same are true and correct. So help me God.

(Signature) Laura Bowdle
El Dorado, Kansas (Address)

SUBSCRIBED AND SWORN TO before me this 27th day of October, 19 65

Ronald P. Hannon
Notary Public.

My commission expires 9-27-67