


STATE OF KANSAS  
STATE CORPORATION COMMISSION

WELL PLUGGING RECORD

Give All Information Completely  
Make Required Affidavit  
Mail or Deliver Report to  
Conservation Division  
State Corporation Comm.  
245 North Water  
Wichita, KS 67202

Barber County, Sec. 19 Twp. 31S Rge. 14W E/W  
Location as "NE/CNW $\frac{1}{4}$ SW $\frac{1}{4}$ " or footage from lines  
150' E of C SE/4 SW/4 SE/4  
Lease Owner Gould Oil, Inc. and Logo, Inc.  
Lease Name Thunderbird Ranch Well No. #2  
Office Address P. O. Box 8640, Wichita, Kansas  
Character of Well (Completed as Oil, Gas or Dry Hole)

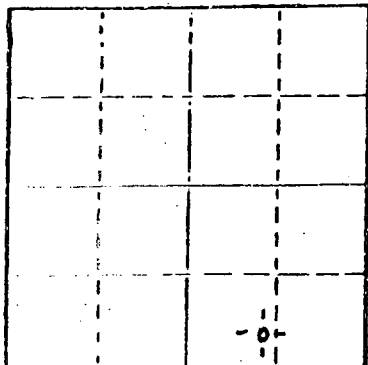

Locate well correctly on above  
Section Plat

Date Well completed November 4, 1981 19  
Application for plugging filed November 4, 1981 19  
Application for plugging approved November 4, 1981 19  
Plugging commenced 2:30 p.m. November 3, 1981 19  
Plugging completed 4:15 a.m. November 4, 1981 19  
Reason for abandonment of well or producing formation

D & A

If a producing well is abandoned, date of last production 19

Was permission obtained from the Conservation Division or  
its agents before plugging was commenced? yes

Name of Conservation Agent who supervised plugging of this well Maurice V. Leslie  
Producing formation X Depth to top X Bottom X Total Depth of Well 4810  
Show depth and thickness of all water, oil and gas formations.

OIL, GAS OR WATER RECORDS

CASING RECORD

FORMATION	CONTENT	FROM	TO	SIZE	PUT IN	PULLED OUT
				8 5/8"	397'	none

Describe in detail the manner in which the well was plugged, indicating where the mud fluid  
was placed and the method or methods used in introducing it into the hold. If cement or other  
plugs were used, state the character of same and depth placed, from \_\_\_\_\_ feet to  
\_\_\_\_\_ feet for each plug set.

- 60 sacks @ 650'
- 50 sacks @ 380'
- 10 sacks @ 40' Bridge
- 10 sacks Rat Hole and 5 sacks Mouse Hole

(If additional description is necessary, use BACK of this sheet)

Name of Plugging Contractor State Corporation Commission of Kansas

STATE OF KANSAS COUNTY OF SEDGWICK, ss.  
Phyllis Buchanan (employee of owner) or (owner or operator)  
of the above-described well, being first duly sworn on oath, says: That I have knowledge of  
the facts, statements, and matters herein contained and the log of the above-described well  
as filed and that the same are true and correct. So help me God.

(Signature) Phyllis Buchanan  
PHYLLIS BUCHANAN  
(Address)

SUBSCRIBED AND SWORN TO before me this 9th day of November, 1981

Sherry Myers  
SHERRY MYERS Notary Public.

My commission expires \_\_\_\_\_

