


WELL PLUGGING RECORD

Give All Information Completely
Make Required Affidavit
Mail or Deliver Report to:
Conservation Division
State Corporation Commission
800 Bitting Building
Wichita, Kansas

Barton County, Sec. 19 Twp. 31 Rge. 14 (W)

Location as "NE/CNW $\frac{1}{4}$ SW $\frac{1}{4}$ " or footage from lines SE SE SE
Lease Owner Anderson-Prichard Oil Corporation
Lease Name Oldfather "A" Well No. 1
Office Address Box 142 - Great Bend, Kansas
Character of Well (completed as Oil, Gas or Dry Hole) Oil
Date well completed April 10, 19 48
Application for plugging filed Nov. 25 (Verbal) Dec. 12 (Written) 19 50
Application for plugging approved December 4 (written) Nov 25 (Verbal) 19 50
Plugging commenced November 27, 19 50
Plugging completed December 2, 19 50
Reason for abandonment of well or producing formation Non Commercial

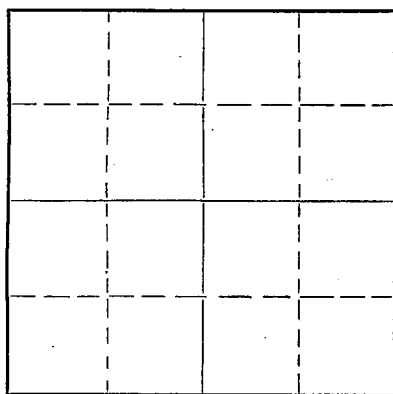

Locate well correctly on above Section Flat

If a producing well is abandoned, date of last production May 7, 19 50
Was permission obtained from the Conservation Division or its agents before plugging was commenced? Yes

Name of Conservation Agent who supervised plugging of this well C. D. Stough
Producing formation Viola Depth to top 4522 Bottom Total Depth of Well PB3859 $\frac{1}{2}$ Feet
Show depth and thickness of all water, oil and gas formations.

OIL, GAS OR WATER RECORDS

CASING RECORD

Formation	Content	From	To	Size	Put In	Pulled Out
				13-3/8	300'	none
				9-5/8	972'	none
				5-1/2	4525'	3100'

Describe in detail the manner in which the well was plugged, indicating where the mud fluid was placed and the method or methods used in introducing it into the hole. If cement or other plugs were used, state the character of same and depth placed, from _____ feet to _____ feet for each plug set.

Filled hole back from 3859 $\frac{1}{2}$ ' with crushed rock to 3800'
Dumped 5 sax cement with bailer
Shot casing off at 3215'
Pulled casing out and filled hole with heavy mud to 250'
Set permanent rock bridge and dumped 20 sax cement
Filled hole with mud to 20' off top.
Mixed 15 sax cement for cap on well.

RECEIVED
STATE CORPORATION COMMISSION
12-13-50
DEC 13 1950
CONSERVATION DIVISION
Wichita, Kansas

(If additional description is necessary, use BACK of this sheet)

Correspondence regarding this well should be addressed to W. J. Dearen & Anderson-Prichard Oil Corp.
Address Box 142 - Great Bend, Kansas

STATE OF KANSAS, COUNTY OF BARTON, ss.
Gerald M. Dougherty (employee of owner) or (owner or operator) of the above-described well,
being first duly sworn on oath, says: That I have knowledge of the facts, statements, and matters herein contained and the log of the above-described well as filed and that the same are true and correct. So help me God.

(Signature) *Gerald M. Dougherty*
Box 142 - Great Bend, Kansas
(Address)

SUBSCRIBED AND SWORN to before me this 12th. day of December, 19 50

Anna M. Laudick
Notary Public.

My commission expires April 26, 1952

PLUGGING
FILE SEC. 19 T 31 R 14
BOOK PAGE 46 LINE 29

Anderson-Prichard Oil Corp.
Oldfather Well # "A" 1.
Total Depth 4536
Comm. 12/13/47
Comp. 1/24/48

Located 6, SE/4, SE/4, SE/4,
Sec 19, T31S, R14W,
Barber County, Kansas.
CASING RECORD
13 3/8" Casing at 300Ft.
Cemented with 300 Sacks Cement
9 5/8" Casing at 972Ft.
Cemented with 300 Sacks Cement
5 1/2" Casing at 4525Ft.
Cemented with 300 Sacks Cement

Red Beds	65
Sand	115
Red Beds & Shells	210
Red Shale & Shells	575
Red Bed	820
Shale & Shells	1280
Salt	1380
Shale & Shells	1665
Salt & Shale	1740
Shale	1815
Anhydrite	1835
Lime Brown	1960
Lime & Shale	2080
Lime	2640
Lime & Shale	3005
Shale & Shells	3060
Shale	3125
Lime	3260
Lime & Shale	3320
Lime	3465
Lime & Shale	3945
Lime Sandy	3970
Lime	4384
Lime & Shale	4445
Lime	4475
Lime & Shale	4535
Lime	4536
Total Depth	4536

RECEIVED
STATE DEPARTMENT OF COMMISSIONS
12-13-50
DEC 13 1950
WICHIITA DIVISION

STATE OF Kansas COUNTY OF Adair ss,

I, the undersigned, being duly sworn, on oath state that the above statement and log is a true and correct record and log of the well drilled at the location above described.

R. C. PATTON CO.,
By R.C. Patton

Subscribed and sworn to before me this 11th day of May 1948
R.P. Prichard
Notary Public

My Commission expires Oct 4th 1948

PLUGGING
FILE SEC 19 T 31 R 14W
BOOK PAGE 46 LINE 29

FILED
1948
MAY 13 1948
BARBER COUNTY, KANSAS