


15-007-0031-0000

WELL PLUGGING RECORD

Give All Information Completely
Make Required Affidavit
Mail or Deliver Report to:
Conservation Division
State Corporation Commission
212 North Market, Insurance Bldg.
Wichita, Kansas

NORTH

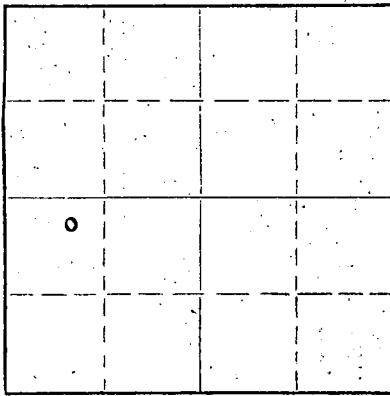

Locate well correctly on above Section Plat

Barber County, Sec. 19 Twp. 31 Rge. (E) 14 (W)
Location as "NE/CNW&SW" or footage from lines 150' E. of CNE NW SW
Lease Owner Lario Oil & Gas Company
Lease Name Shaft "C" Well No. 1
Office Address 301 S. Market, Wichita, Kansas
Character of Well (completed as Oil, Gas or Dry Hole) Dry Hole
Date well completed November 19, 1961
Application for plugging filed November 19, 1961
Application for plugging approved November 19, 1961
Plugging commenced November 19, 1961
Plugging completed November 19, 1961
Reason for abandonment of well or producing formation Dry Hole

If a producing well is abandoned, date of last production 19
Was permission obtained from the Conservation Division or its agents before plugging was commenced? Yes

Name of Conservation Agent who supervised plugging of this well Fred Hampel
Producing formation _____ Depth to top _____ Bottom _____ Total Depth of Well 4875 Feet
Show depth and thickness of all water, oil and gas formations.

OIL, GAS OR WATER RECORDS

CASING RECORD

FORMATION	CONTENT	FROM	TO	SIZE	PUT IN	PULLED OUT
				8 5/8"	1190.30	Set @ 1194' Cem. w/ 870 sacks

Describe in detail the manner in which the well was plugged, indicating where the mud fluid was placed and the method or methods used in introducing it into the hole. If cement or other plugs were used, state the character of same and depth placed, from _____ feet to _____ feet for each plug set.

Filled hole with heavy mud from total depth to 500'. Set plug at 500' with 1/4 sack hulls and 20 sacks cement. Mud to 40'. Set plug at 40' with 1/4 sack hulls; 10 sacks cement to base of cellar.

RECEIVED
STATE CORPORATION COMMISSION
NOV 30 1961
11-30-61
CONSERVATION DIVISION
Wichita, Kansas

(If additional description is necessary, use BACK of this sheet)
Name of Plugging Contractor Patton Drilling Company, Inc.
Address Wichita, Kansas

STATE OF KANSAS, COUNTY OF SEDGWICK, ss.
Leo Ross (employee of owner) or (owner/operator) of the above-described well, being first duly sworn on oath, says: That I have knowledge of the facts, statements, and matters herein contained and the log of the above-described well as filed and that the same are true and correct. So help me God.

(Signature) Leo Ross
301 S. Market, Wichita 2, Kansas
(Address)

SUBSCRIBED AND SWORN TO before me this 29th day of November, 19 61

My commission expires July 21, 1962 Frances Leslie Notary Public.



15-007-00031-0000

LARIO OIL & GAS COMPANY
Shaft "C" No. 1
NE NW SW Sec. 19-31S-14W
Barber County, Kansas

Drilling Commenced: October 22, 1961
Drilling Completed: November 19, 1961
Drilling Contractor: Patton Drilling Company, Inc.
Total Depth - 4875'
I.P. - Dry & Abandoned

CASING RECORD:

8 5/8" 1190.30' (o.a.) Set @ 1194'
Cem. w/ 870 sacks

Formation	Depth
Gyp and red bed	74
Red bed	325
Red bed & gypsum shells	725
Shale, anhydrite, shells	960
Shale & anhydrite	1153
Shale & shells	1934
Shale	2080
Lime & shale	3145
Lime & sandy shale	3192
Lime, shale & sand	3267
Shale & lime	3560
Lime & shale	3920
Shale & lime	4015
Lime & shale	4197
Lime	4558
Cherty lime	4577
Lime	4609
Cherty lime	4670
Lime	4713
Chalky lime & shale	4727
Lime	4790
Sand & shale	4815
Sandy shale	4860
Lime Arbuckle	4875

GEOLOGICAL TOPS - K.B. MEAS.

Elevation		
	1846'	K.B.
	1844'	D.F.
	1838'	G.L.
Tarkio Sand Zone	2956'	-1110'
Tarkio Lime	3130'	-1284'
Topeka	3452'	-1606'
Heebner	3840'	-1994'
Douglas Shale	3883'	-2037'
Douglas Sandstone	3992'	-2146'
Lansing	4016'	-2170'
Marmaton-Massey Zone	4468'	-2622'
Mississippian Conglomerate	4552'	-2706'
Viola	4601'	-2755'
Simpson Sand	4720'	-2874'
Arbuckle	4841'	-2995'
Rotary Total Depth	4875'	-3029'
Welox Total Depth	4875'	-3029'

I hereby certify that this is a true and correct log of the above mentioned well.

[Signature]

STATE OF KANSAS)
COUNTY OF SEDGWICK) ss

Subscribed and sworn to before me, a notary public, in and for said County and State this 29th day of November, 1961.

[Signature]
Notary Public

My Commission expires July 21, 1962.

RECEIVED
STATE CORPORATE COMMISSION
NOV 30 1961
CONSERVATION DIVISION
Wichita, Kansas