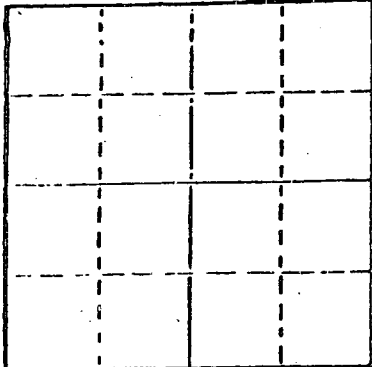


STATE OF KANSAS
STATE CORPORATION COMMISSION

WELL PLUGGING RECORD

Give All Information Completely
Make Required Affidavit
Mail or Deliver Report to
Conservation Division
State Corporation Comm.
245 North Water
Wichita, KS 67202

Locate well correctly on above
Section Plot

Barber County. Sec. 35 Twp. 31 Rge. 14W E/W
Location as "NE/CNW1SW1" or footage from lines
C. SW NE

Lease Owner Stan Bell
Lease Name Harbaugh Well No. 1
Office Address 360 N. 135th Street West, Wichita, KS
Character of Well (Completed as Oil, Gas or Dry Hole) dry hole

Date Well completed September 17, 1978 19
Application for plugging filed September 17, 1978 19
Application for plugging approved September 17, 1978 19
Plugging commenced September 17, 1978 19
Plugging completed September 17, 1978 19
Reason for abandonment of well or producing formation dry hole

If a producing well is abandoned, date of last production 19

Was permission obtained from the Conservation Division or its agents before plugging was commenced? yes

Name of Conservation Agent who supervised plugging of this well Wm. T. Owen
Producing formation Depth to top Bottom Total Depth of Well 460
Show depth and thickness of all water, oil and gas formations.

OIL, GAS OR WATER RECORDS

CASING RECORD

FORMATION	CONTENT	FROM	TO	SIZE	PUT IN	PULLED OUT

Describe in detail the manner in which the well was plugged, indicating where the mud fluid was placed and the method or methods used in introducing it into the hold. If cement or other plugs were used, state the character of same and depth placed, from feet to feet for each plug set.

First plug set at 600' with 40 sacks
Second plug set at 30' with 12 sacks
Three sacks in rat hole

RECEIVED
STATE CORPORATION COMMISSION

OCT 26 1978

10-26-78

CONSERVATION DIVISION
Wichita, Kansas

(If additional description is necessary, use BACK of this sheet)

Name of Plugging Contractor Union Drilling Co., Inc.

STATE OF KANSAS COUNTY OF SEDGWICK ss.
R. D. Messinger (employee of owner) or (owner or operator)
of the above-described well, being first duly sworn on oath, says: That I have knowledge of the facts, statements, and matters herein contained and the log of the above-described well as filed and that the same are true and correct. So help me God?

(Signature)

505 Union Center, Wichita, Kansas
(Address)

SUBSCRIBED AND SWORN TO before me this 20th day of September, 1978

My commission expires

6-2-82

Cynthia L. Romey

Notary Public.

15-007-20671-0000

CONTRACTORS WELL LOG

OPERATOR:
CONTRACTOR:
WELL NAME:
LOCATION:

Stan Bell
Union Drilling Co., Inc.
#1 Harbaugh
C SW NE Sec. 35-31S-14W
Barber County, Kansas
September 6, 1978
September 17, 1978

COMMENCED:
COMPLETED:

0	288	Sand and red bed	Set 8-5/8" @ 828' w/500 sacks
288	525	Red bed, shale, sand and shells	
525	949	Red bed	
949	1095	Red bed and shale	
1095	1400	Shale	
1400	1940	Shale and lime	
1940	2102	Shale	
2102	2510	Shale and lime	
2510	2697	Shale	
2697	3540	Shale and lime	
3540	3756	Lime	
3756	4025	Lime and shale	
4025	4160	Shale and lime	
4160	4195	Lime and shale	
4195	4460	Lime	
	4460	T. D.	

RECEIVED
STATE CORPORATION COMMISSION

OCT 26 1978
10-26-78
CONSERVATION DIVISION
Wichita, Kansas

We certify that the above and foregoing is a true and correct copy of the log on the #1 Harbaugh, C SW NE Section 35-31S-14W, Barber County, Kansas.

UNION DRILLING CO., INC.

R. D. Messinger
R. D. Messinger

STATE OF KANSAS)
) SS
COUNTY OF SEDGWICK)

Subscribed and sworn to before me, a Notary Public, in and for the aforesaid County and State as of this 20th day of September, 1978.

My appointment expires:

6-2-82

Cynthia L. Romey
Cynthia L. Romey - Notary Public

