


STATE OF KANSAS  
STATE CORPORATION COMMISSION

WELL PLUGGING RECORD

Give All Information Completely  
Make Required Affidavit  
Mail or Deliver Report to  
Conservation Division  
State Corporation Comm.  
245 North Water  
Wichita, KS 67202

Barber County, Sec. 33 Twp. 31S Rge. 14W ~~R&W~~  
Location as "NE/CNW $\frac{1}{4}$ /SW $\frac{1}{4}$ " or footage from lines \_\_\_\_\_  
240' E of C NW SE  
Lease Owner D. R. Lauck Oil Company, Inc.  
Lease Name Skinner Well No. 1  
Office Address 221 S. Broadway, Wichita, Kansas 67202  
Character of Well (Completed as Oil, Gas or Dry Hole) \_\_\_\_\_

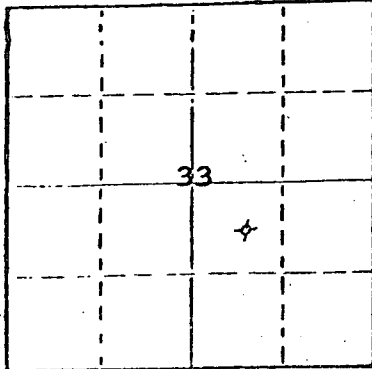

Locate well correctly on above  
Section Plot

Dry Hole  
Date Well completed September 4, 1978  
Application for plugging filed September 4, 1978  
Application for plugging approved September 4, 1978  
Plugging commenced September 4, 1978  
Plugging completed September 4, 1978  
Reason for abandonment of well or producing formation \_\_\_\_\_

Dry Hole  
If a producing well is abandoned, date of last production \_\_\_\_\_  
19 \_\_\_\_\_

Was permission obtained from the Conservation Division or  
its agents before plugging was commenced? Yes

Name of Conservation Agent who supervised plugging of this well Wm. T. Owen  
Producing formation \_\_\_\_\_ Depth to top \_\_\_\_\_ Bottom \_\_\_\_\_ Total Depth of Well 4755'  
Show depth and thickness of all water, oil and gas formations.

OIL, GAS OR WATER RECORDS

CASING RECORD

FORMATION	CONTENT	FROM	TO	SIZE	PUT IN	PULLED OUT
		0'	343'	8-5/8"	336.70'	None

Describe in detail the manner in which the well was plugged, indicating where the mud fluid was placed and the method or methods used in introducing it into the hold. If cement or other plugs were used, state the character of same and depth placed, from \_\_\_\_\_ feet to \_\_\_\_\_ feet for each plug set.

Plugged with 40 sacks cement & plug at 343'  
12 sacks and plug at 40'.

RECEIVED  
STATE CORPORATION COMMISSION

SEP 06 1978  
7-6-78  
CONSERVATION DIVISION  
Wichita, Kansas

(If additional description is necessary, use BACK of this sheet)

Name of Plugging Contractor Allied Cementing Co.

STATE OF KANSAS COUNTY OF SEDGWICK, ss.  
John D. Knightley (employee of owner) or (owner or operator)  
of the above-described well, being first duly sworn on oath, says: That I have knowledge of the facts, statements, and matters herein contained and the log of the above-described well as filed and that the same are true and correct. So help me God.

(Signature)

221 S. Broadway, Wichita, Kansas  
(Address)

SUBSCRIBED AND SWORN TO before me this 5th day of September, 1978

Stella J. Lipps  
Notary Public.

My commission expires March 12, 1979

D. R. Lauck Oil Company, Inc. - Skinner #1  
240' E of C NW SE  
Sec. 33-31S-14W  
Barber County, Kansas

Contractor: D. R. Lauck Oil Company, Inc.  
221 S. Broadway, Suite 400  
Wichita, Kansas 67202

Commenced: August 24, 1978  
Completed: September 4, 1978

Drillers Log

Red Bed & Shale	46
Red Bed & Gyp	102
Shale & Shells	904
Shale	2350
Shale & Lime	2955
Lime & Shale	3918
Lime	4755 RTD

RECEIVED  
STATE CORPORATION COMMISSION

SEP 06 1978  
9-6-78  
CONSERVATION DIVISION  
Wichita, Kansas