15-077-20034-00-00


STATE OF KANSAS
STATE CORPORATION COMMISSION

Form CP-4

Give All Information Completely
Make Required Affidavit
Mail or Deliver Report to:
Conservation Division
State Corporation Commission
212 No. Market
Wichita, Kansas

WELL PLUGGING RECORD

NORTH

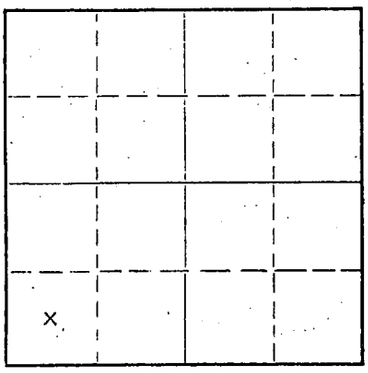

Locate well correctly on above Section Plat

Harper County. Sec. 5 Twp. 34 Rge. 5 (E) (W)

Location as "NE/CNW¼SW¼" or footage from lines C SW SW

Lease Owner Dorset Company

Lease Name H & H Unit Well No. 1

Office Address 610 Nat'l Bank of Tulsa Bldg. Tulsa, Okla.

Character of Well (completed as Oil, Gas or Dry Hole) D & A

Date well completed 10-10-67 19

Application for plugging filed 10-24-67 19

Application for plugging approved 10-25-67 19

Plugging commenced 10-30-67 19

Plugging completed 10-31-67 19

Reason for abandonment of well or producing formation

If a producing well is abandoned, date of last production 19

Was permission obtained from the Conservation Division or its agents before plugging was commenced? yes

Name of Conservation Agent who supervised plugging of this well Archie Elving

Producing formation Depth to top Bottom Total Depth of Well 3785 Feet

Show depth and thickness of all water, oil and gas formations.

OIL, GAS OR WATER RECORDS — CASING RECORD

FORMATION	CONTENT	FROM	TO	SIZE	PUT IN	PULLED OUT
				8 5/8"	207'	none
				5½"	3784'	3410'

Describe in detail the manner in which the well was plugged, indicating where the mud fluid was placed and the method or methods used in introducing it into the hole. If cement or other plugs were used, state the character of same and depth placed, from feet to feet for each plug set.

XXXX Fill hole from 3785' to 3770' and dump 5 sacks of cement

Set 10' rock bridge from 200' to 190' and dump 25 sacks of cement

Mud hole to 40', rock to 30', and dump 10 sacks of cement to surface

RECEIVED
STATE CORPORATION COMMISSION
NOV 9 1967
CONSERVATION DIVISION
Wichita, Kansas

(If additional description is necessary, use BACK of this sheet)

Name of Plugging Contractor Flint Engineering and Const. Co.

Address 2375 W. Central El Dorado, Kansas

STATE OF Kansas, COUNTY OF Butler, ss.

(employee of owner) or (owner or operator) of the above-described well, being first duly sworn on oath, says: That I have knowledge of the facts, statements, and matters herein contained and the log of the above-described well as filed and that the same are true and correct. So help me God.

(Signature) Kenneth Smith

(Address)

SUBSCRIBED AND SWORN TO before me this 8 day of November 19 67

Jeanne C. Davis
Notary Public.

My commission expires Sept. 19, 1971

JEANNE C. DAVIS NOTARY PUBLIC BUTLER COUNTY, KANSAS JULY

GABBERT-JONES, INC.
WICHITA, KANSAS
DRILLERS' WELL LOG

H & H UNIT #1
C SW¼ SW¼ SECTION 5-34S-5W
HARPER COUNTY, KANSAS

COMMENCED: OCTOBER 3, 1967
COMPLETED: OCTOBER 10, 1967

OPERATOR - DORSET COMPANY

DEPTH From	DEPTH To	FORMATION	REMARKS
0	50	RED BED	
50	100	SAND	
100	207	SHALE	RAN 11 JOINTS 8-5/8" CSG., SET @ 207' W/175 SX. CEMENT.
207	320	RED BED	
320	600	RED BED AND SHALE	
600	1390	SHALE AND SHELLS	
1390	2290	LIME AND SHALE	
2290	2450	SHALE AND SHELLS	
2450	3400	SHALE AND LIME	
3400	3490	SHALE	
3490	3558	SAND	
3558	3650	SHALE	
3650	3750	LIME AND SHALE	
3750	3780	SHALE	
3780	3785	LIME	
3785	TD		RAN 125 JOINTS 5½" CSG., SET @ 3784 W/50 SX. CEMENT.

RECEIVED
STATE CORPORATION COMMISSION
OCT 27 1967
CONSERVATION DIVISION
Wichita, Kansas

I, E. E. HALL, CERTIFY THIS IS A CORRECT COPY OF THE DRILLERS' LOG FOR THE WELL DRILLED IN THE C SW¼ SW¼ SECTION 5-34S-5W, HARPER COUNTY, KANSAS, TO THE BEST OF MY KNOWLEDGE AND BELIEF.

E. E. HALL

STATE OF KANSAS)
) SS
COUNTY OF SEDGWICK)

BEFORE ME, THE UNDERSIGNED, A NOTARY PUBLIC WITHIN AND FOR SAID COUNTY AND STATE, ON THIS 13TH DAY OF OCTOBER, 1967, PERSONALLY APPEARED E. E. HALL, TO ME PERSONALLY KNOWN TO BE THE IDENTICAL PERSON WHO EXECUTED THE WITHIN AND FOREGOING INSTRUMENT AND ACKNOWLEDGED TO ME THAT HE EXECUTED THE SAME AS HIS FREE AND VOLUNTARY ACT AND DEED FOR THE USES AND PURPOSES THEREIN SET FORTH.

IN WITNESS WHEREOF, I HAVE HEREUNTO SET MY HAND AND OFFICIAL SEAL THE DAY AND YEAR LAST ABOVE WRITTEN.

BARBARA J. LAYTON, NOTARY PUBLIC

MY COMMISSION EXPIRES FEBRUARY 1, 1968.

BARBARA J. LAYTON
SEDGWICK COUNTY, KANSAS